


WASHINGTON HAY S.M. CO.


2nd Plan
 No. 1
 1/27/93

WHYTE RIVER


Scale fifty feet to an inch

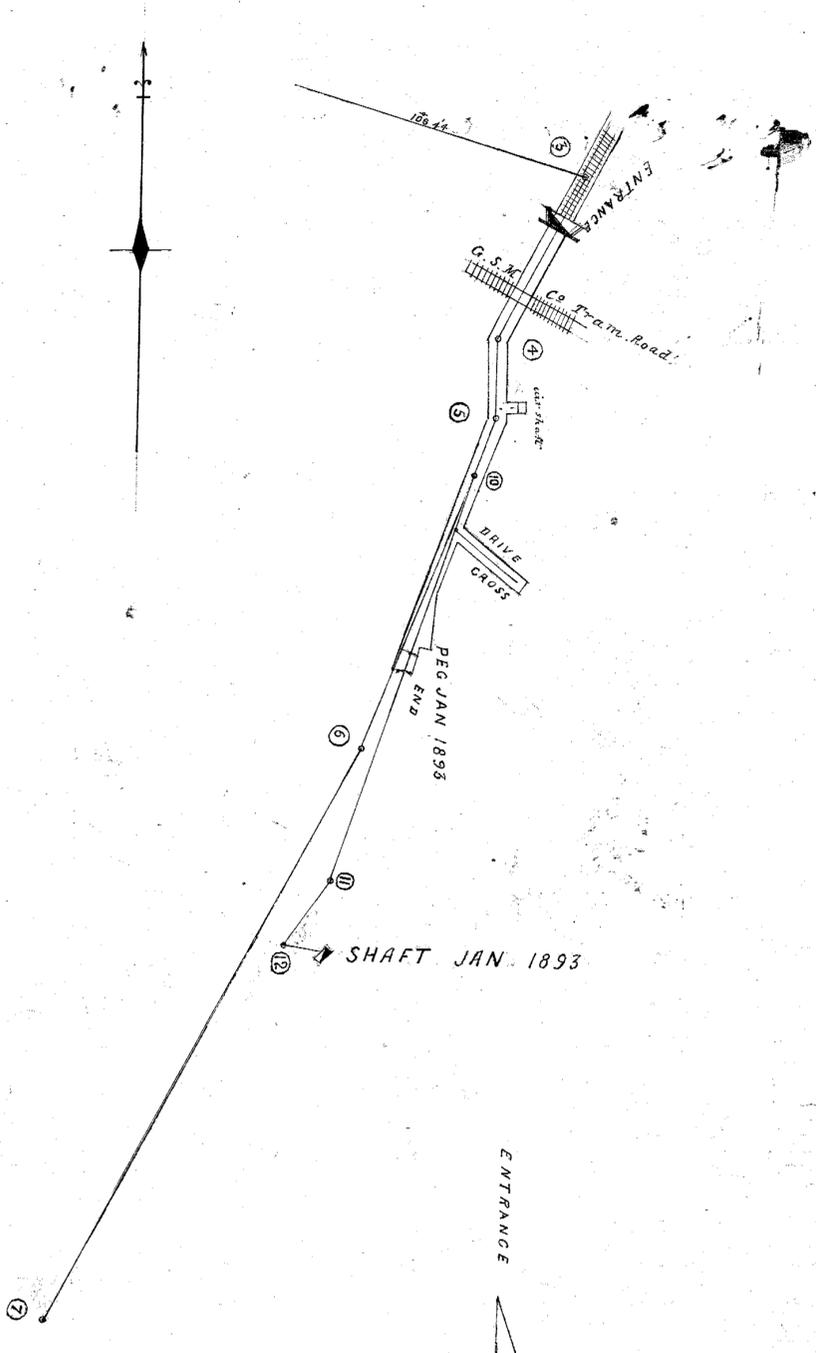

correct
David Jones
District Surveyor
Maraton.
Jan 1893.

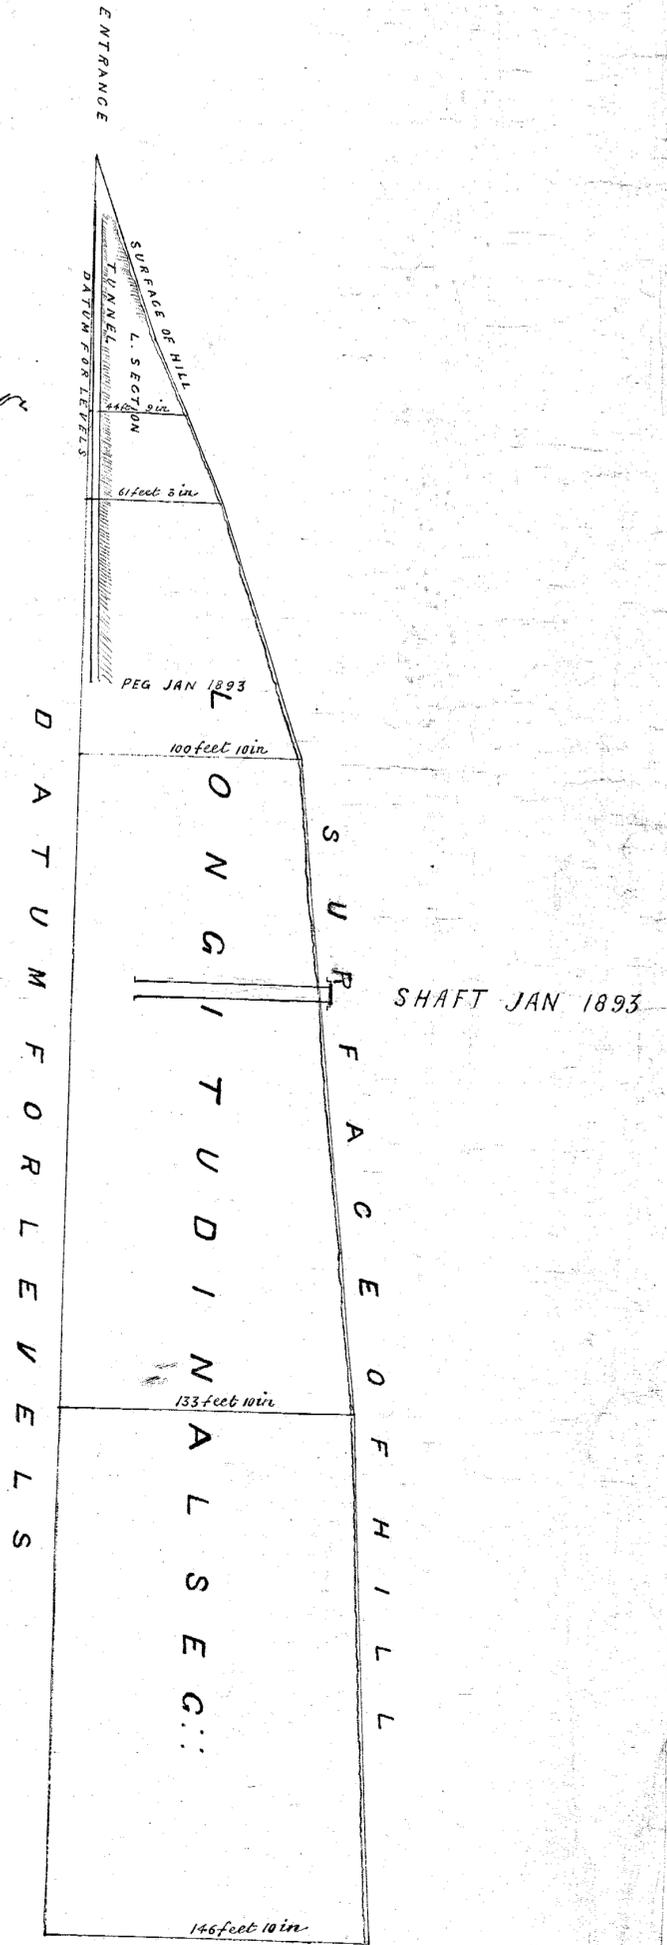

162-02

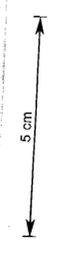

162-09