



162-03

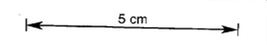

WASHINGTON HAY SM CO.

WHYTE RIVER

Scale fifty feet to one Inch

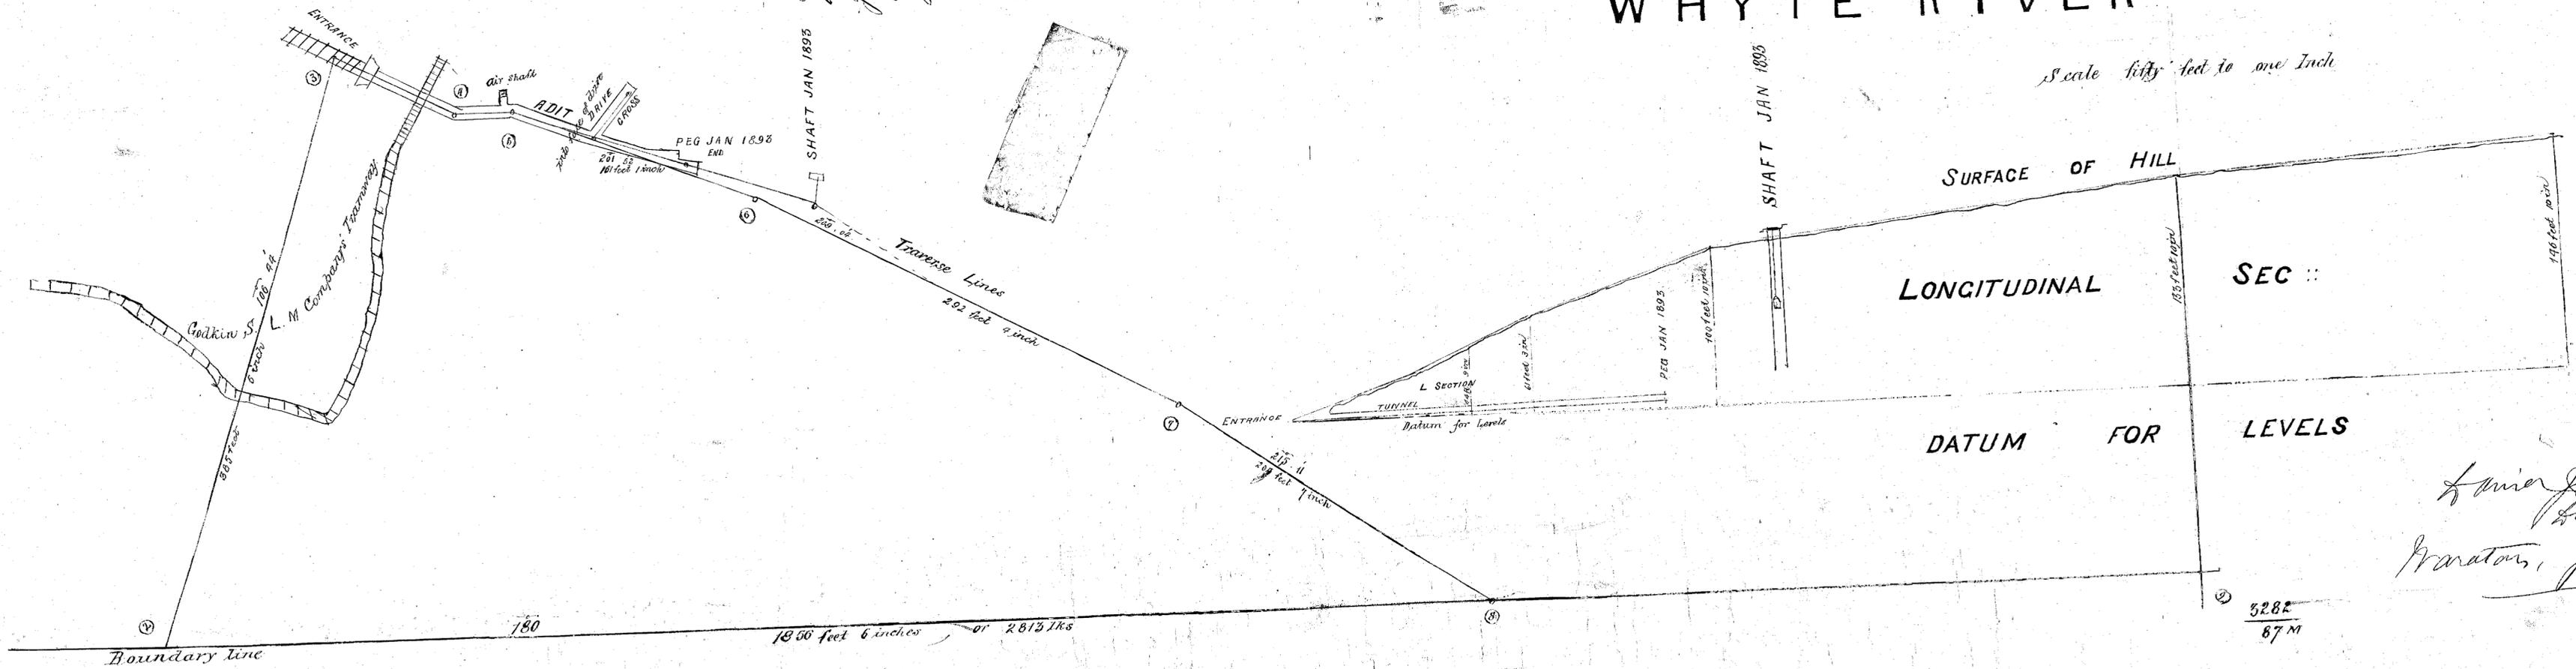

Position of shaft
in correct - see M²
Jones' memo of
April 4th 1893
and fresh plan
then sent

L. M. Jones
District Surveyor
Warrenton, January 1893.

2007
87 M

3282
87 M

W. H. Jones