
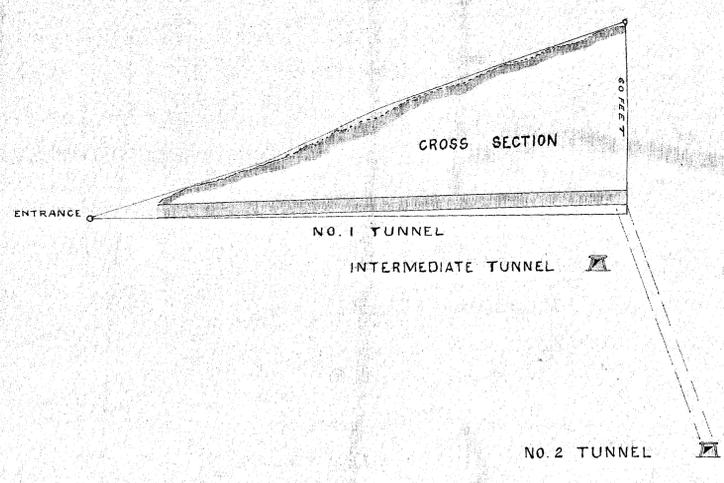


CONFIDENCE  
SILVER MINING CO  
WHYTE RIVER  
1904

Scale 25 Feet to one Inch

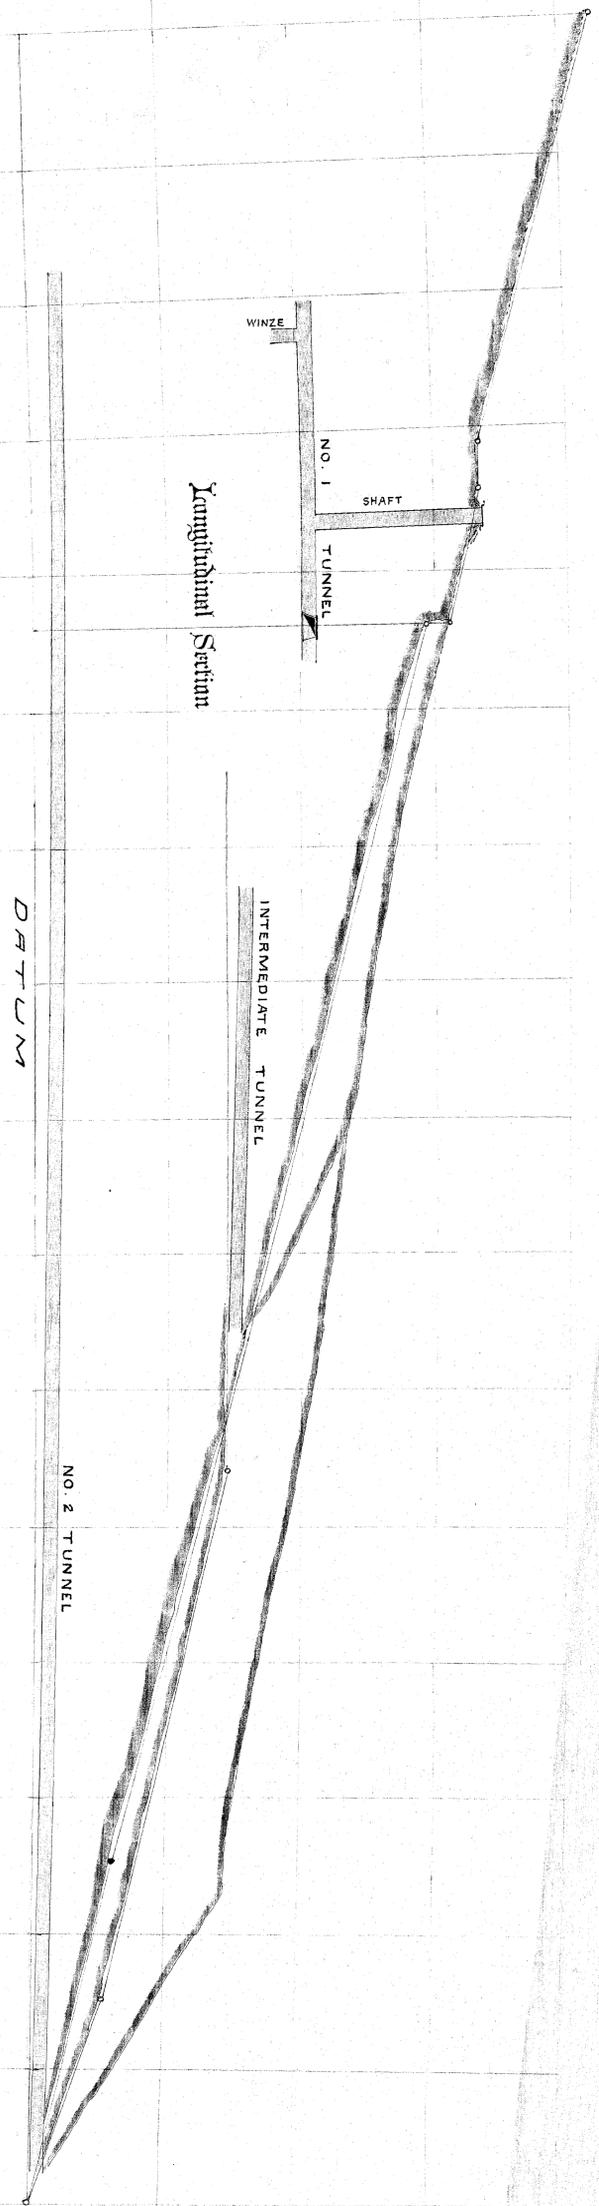

NO 671  
- 93M

40 AC.

I, David Jones, of Waratah, District Surveyor, hereby certify that this plan is sufficiently correct for the purposes of the Mines Act 1900.

*David Jones*  
District Surveyor,

Waratah, Tasmania,  
7<sup>th</sup> March, 1904.

10/3/04

G O D K I N S M C O ' S