



CONFIDENCE

SILVER MINING CO

WHYTE RIVER

1904

Scale 25 Feet to one Inch

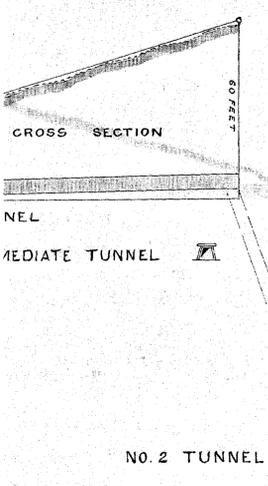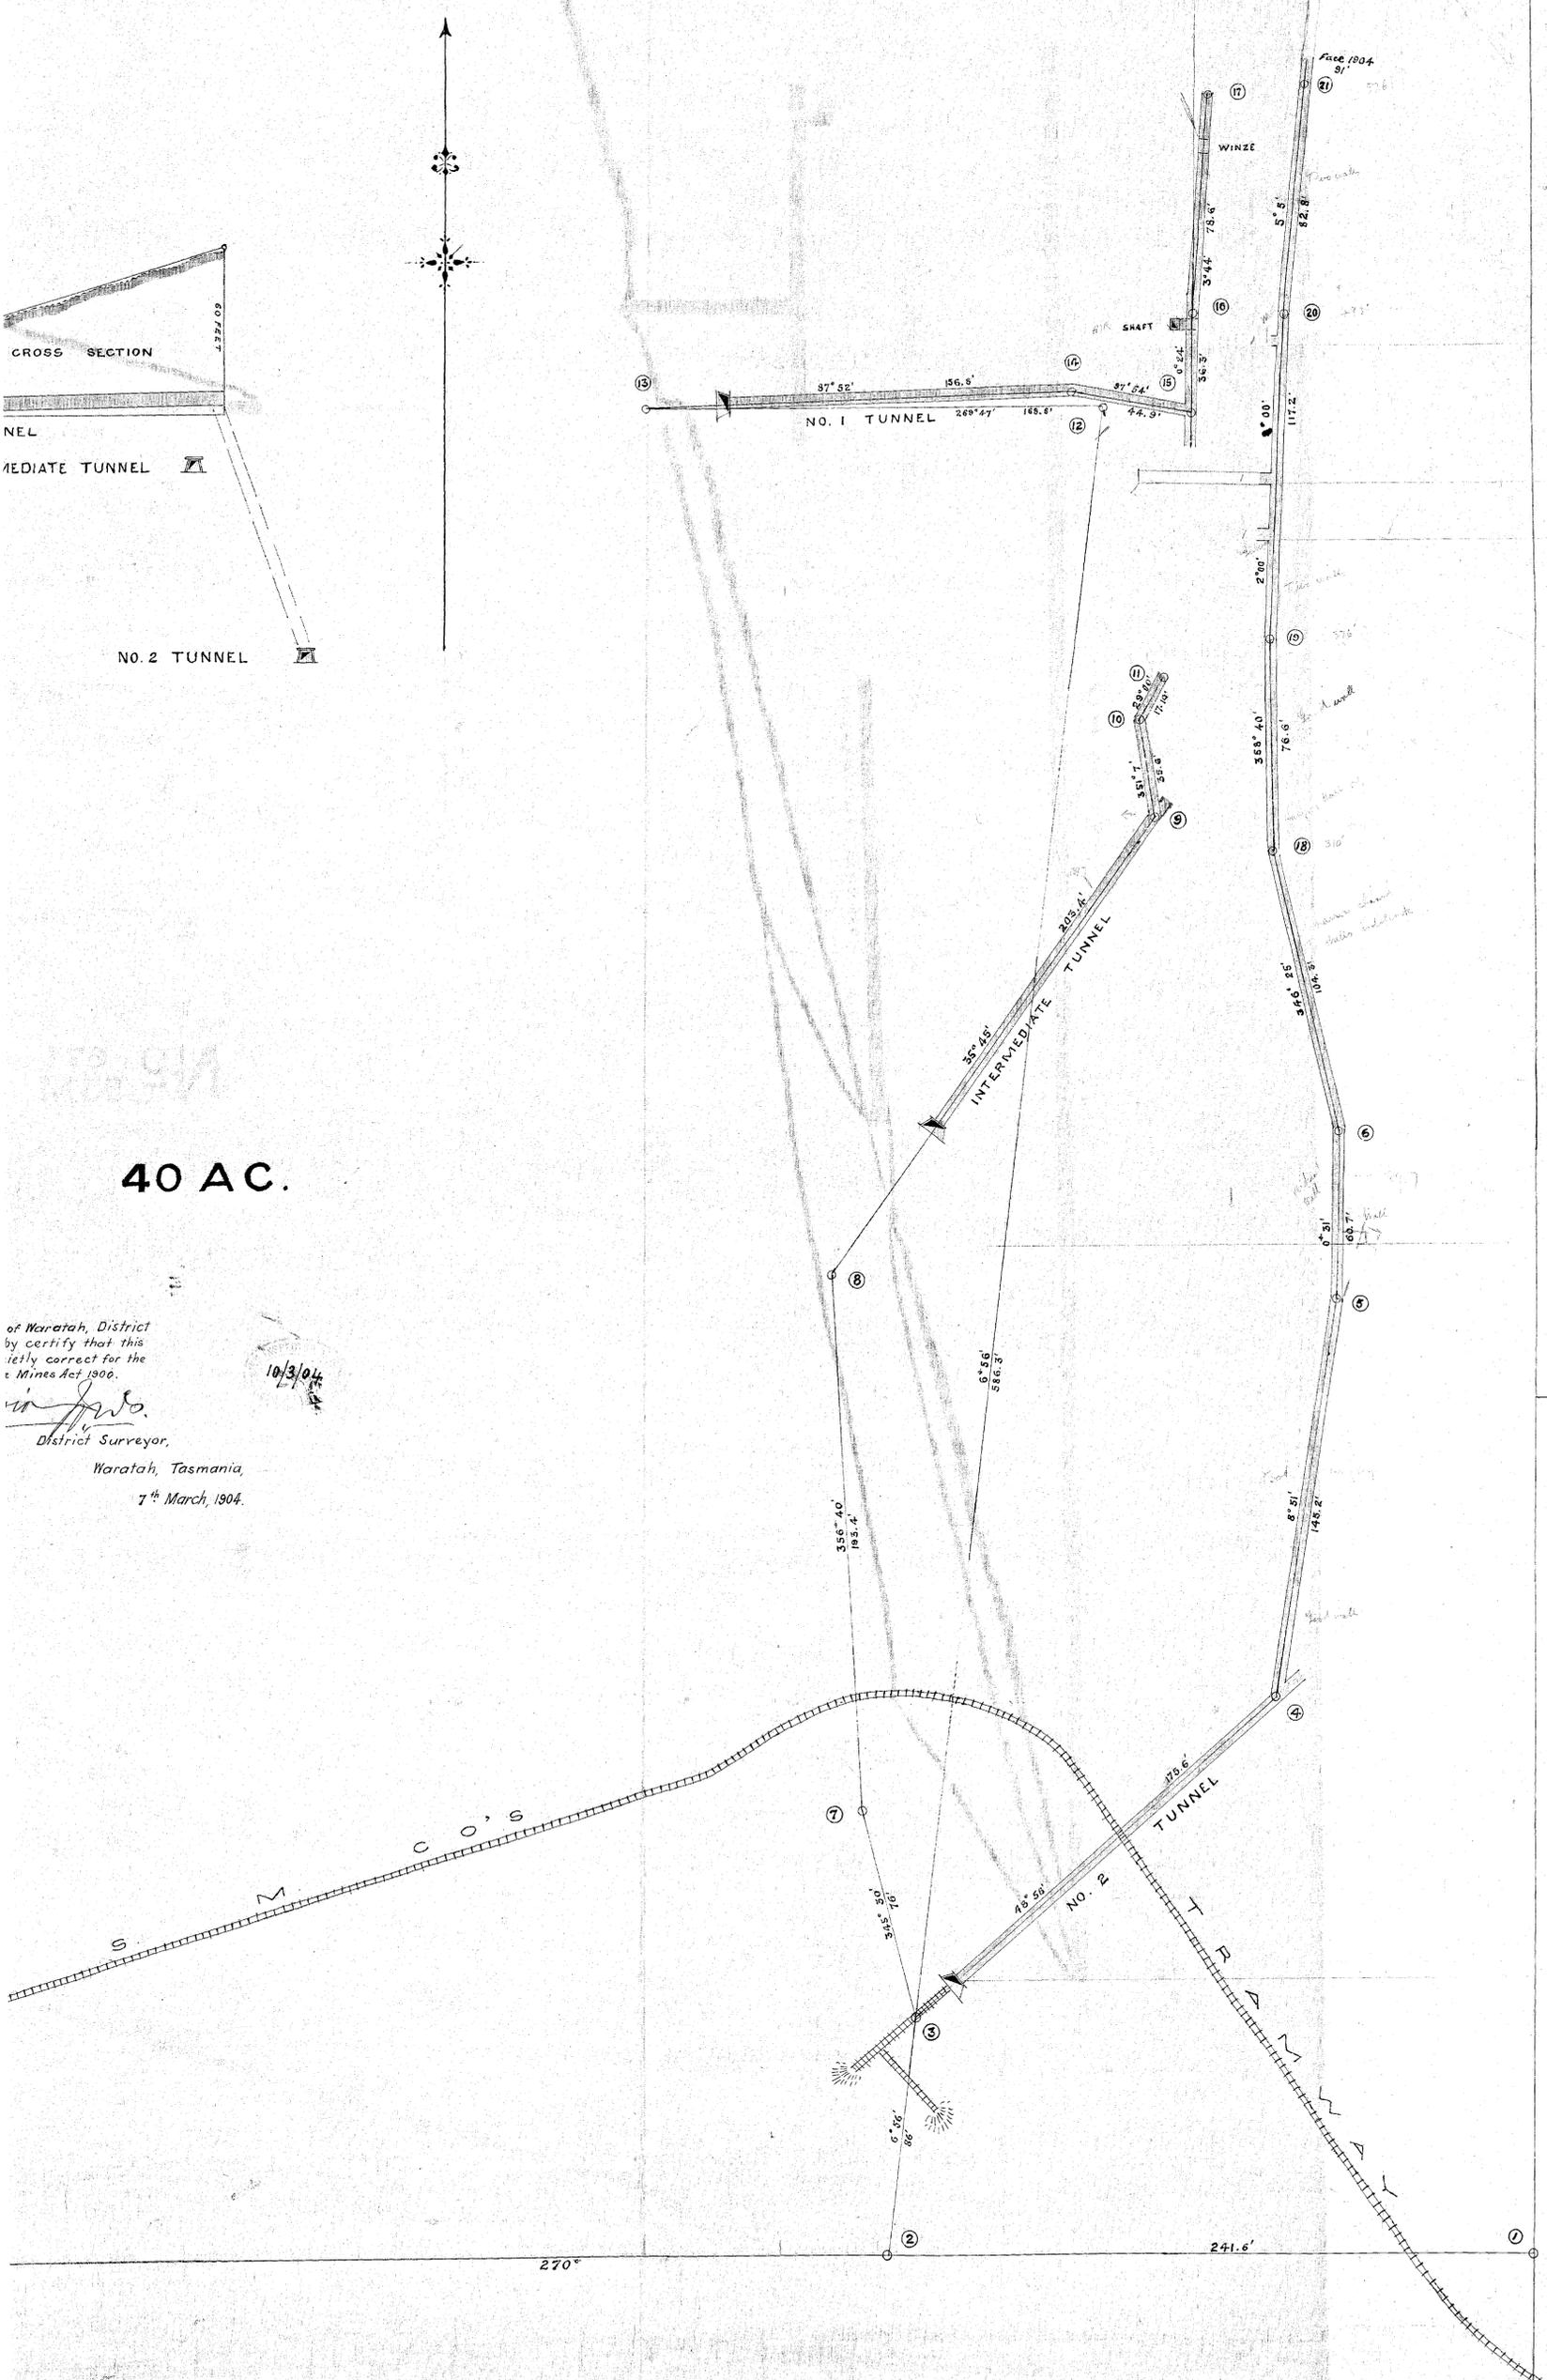

40 AC.

of Waratah, District
 by certify that this
 is correct for the
 Mines Act 1900.

10/3/04

W. J. D.
 District Surveyor,

Waratah, Tasmania,
 7th March, 1904.