





2000 inches

146-α




PLAN
 OF THE
CODKIN S.M. COMPANY'S
 Underground Works
WHYTE RIVER
 Scale 50 Feet to 1 Inch

1712
87 M

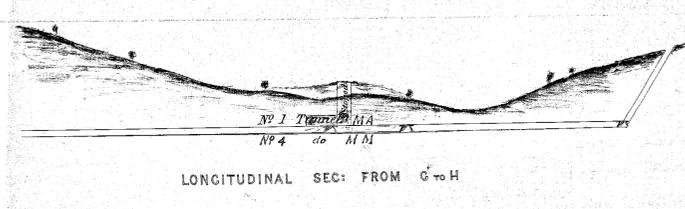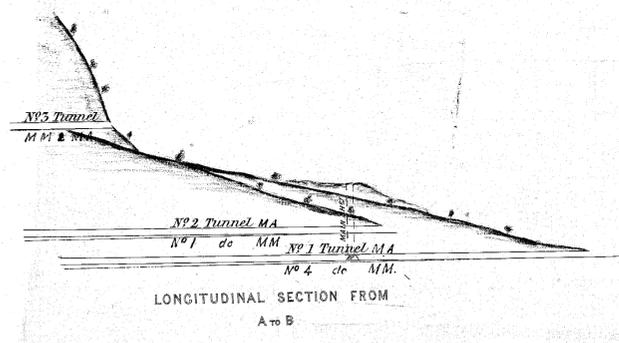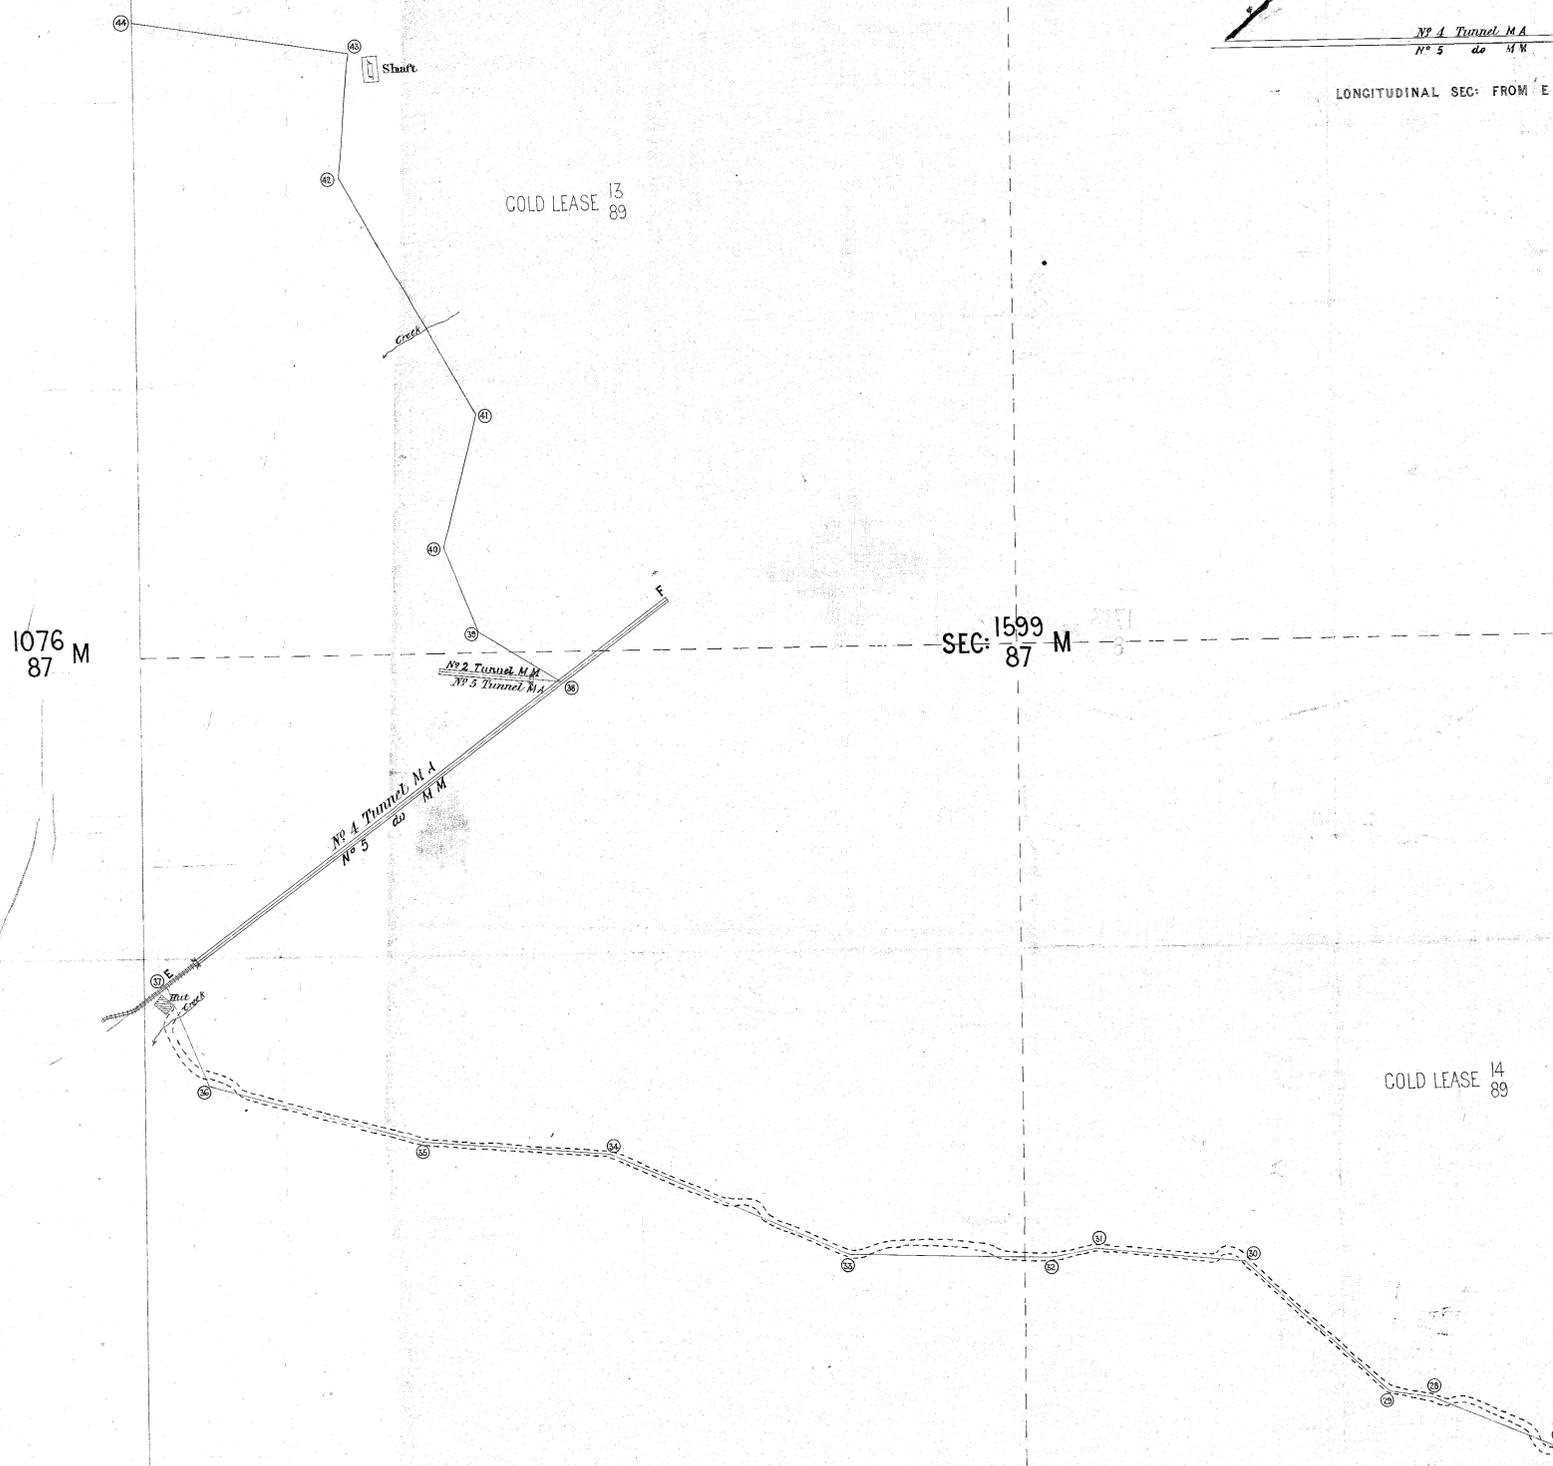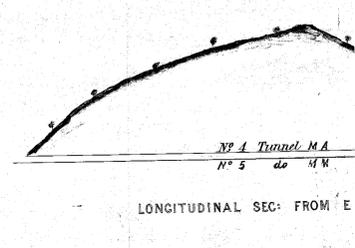

SEC: 1779
87 M

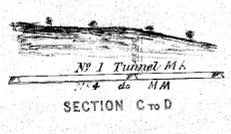

The corrections in red ink were made by me from the first corrected plan. The numbers in the tunnel as given in red ink are the numbers used by the British I.C. Co. they are listed M.M.
 Henry C. Pender
 Manager
 12 July 1874

NOTE: M.A. denotes Mining Act.
 M.M. do Manager.

I, David Jones, Surveyor, of Waratah, hereby declare this plan to be sufficiently correct for the purposes of the Mines Act of 1861.

David Jones
 District Surveyor
 Waratah 1874

J. Murray
 Draftsman