

PLAW

OF THE


CODKIN S. M. COMPANY'S

Underground Works


WHYTE RIVER

Scale 50 Feet to 1 Inch

1712 M
87 M

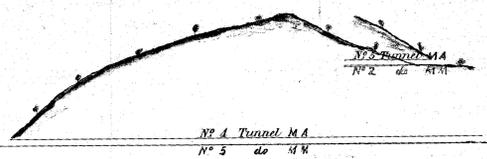


LONGITUDINAL SEC: FROM E TO F

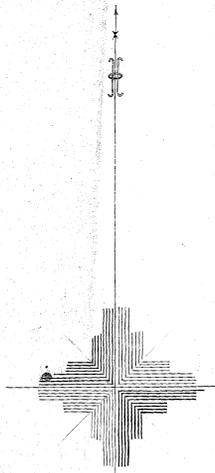

1713 M
87 M

GOLD LEASE 14
89

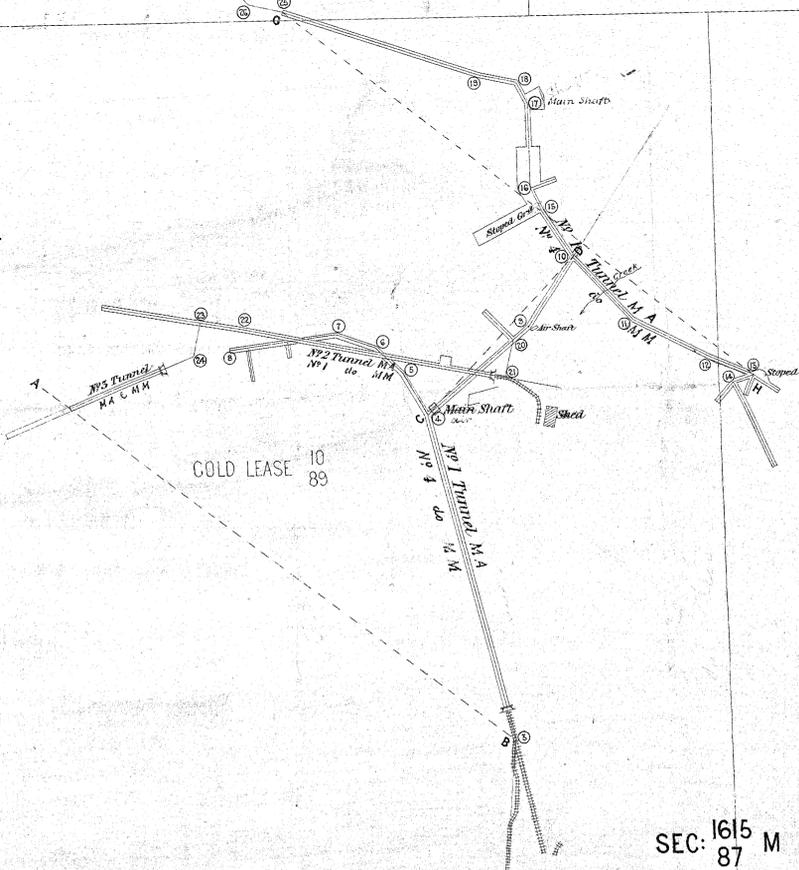

GOLD LEASE 10
89

SEC: 1615
87 M

GOLD LEASE 8
89

Handwritten notes: 'No 1 Tunnel M.A.', 'No 2 Tunnel M.A.', 'No 3 Tunnel M.A.', 'No 4 Tunnel M.A.'.