

1712  
87 M



10

# CODKIN S.M. COMPANY'S

Underground Works

## WHYTE RIVER


Scale 50 Feet to 1 Inch

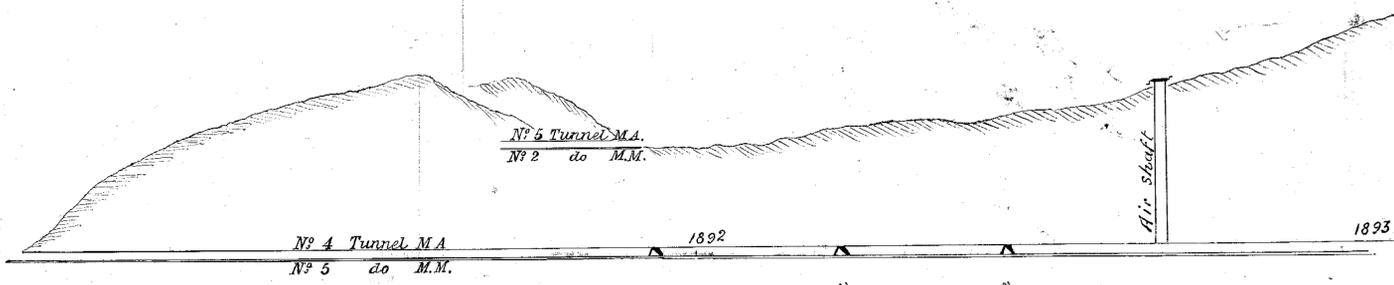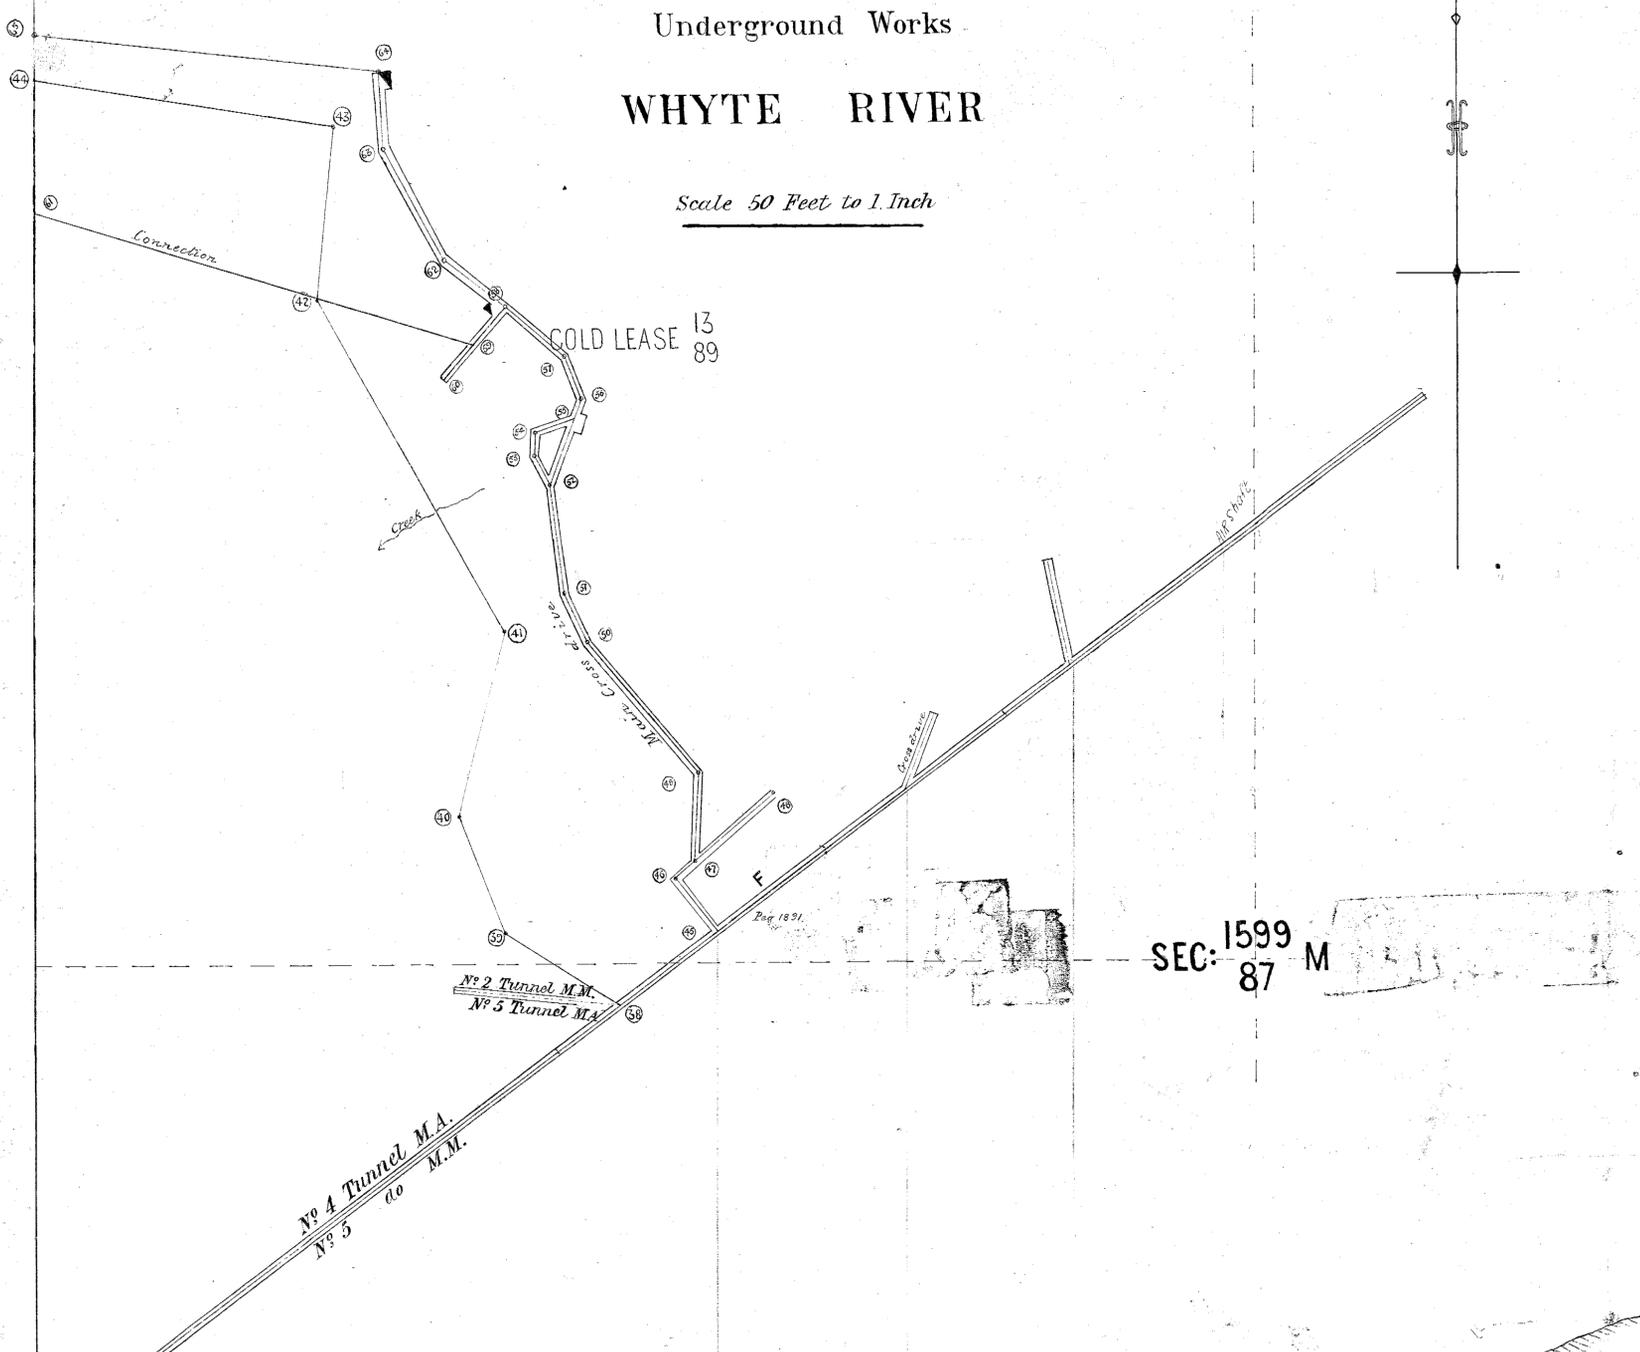

LONGITUDINAL SEC: FROM E TO F

5 cm

*Junior Josko,  
District Surveyor  
Proctor  
Jan. 1893.*

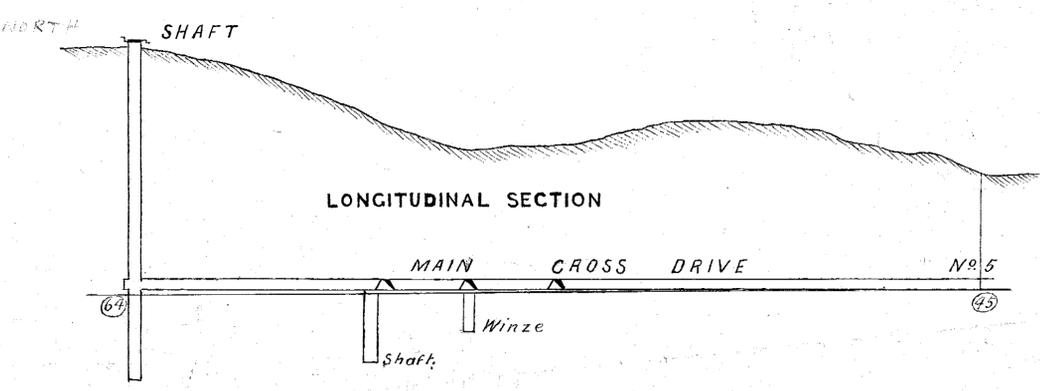

166-02

166-02