



166-03

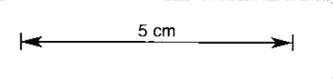

455
②

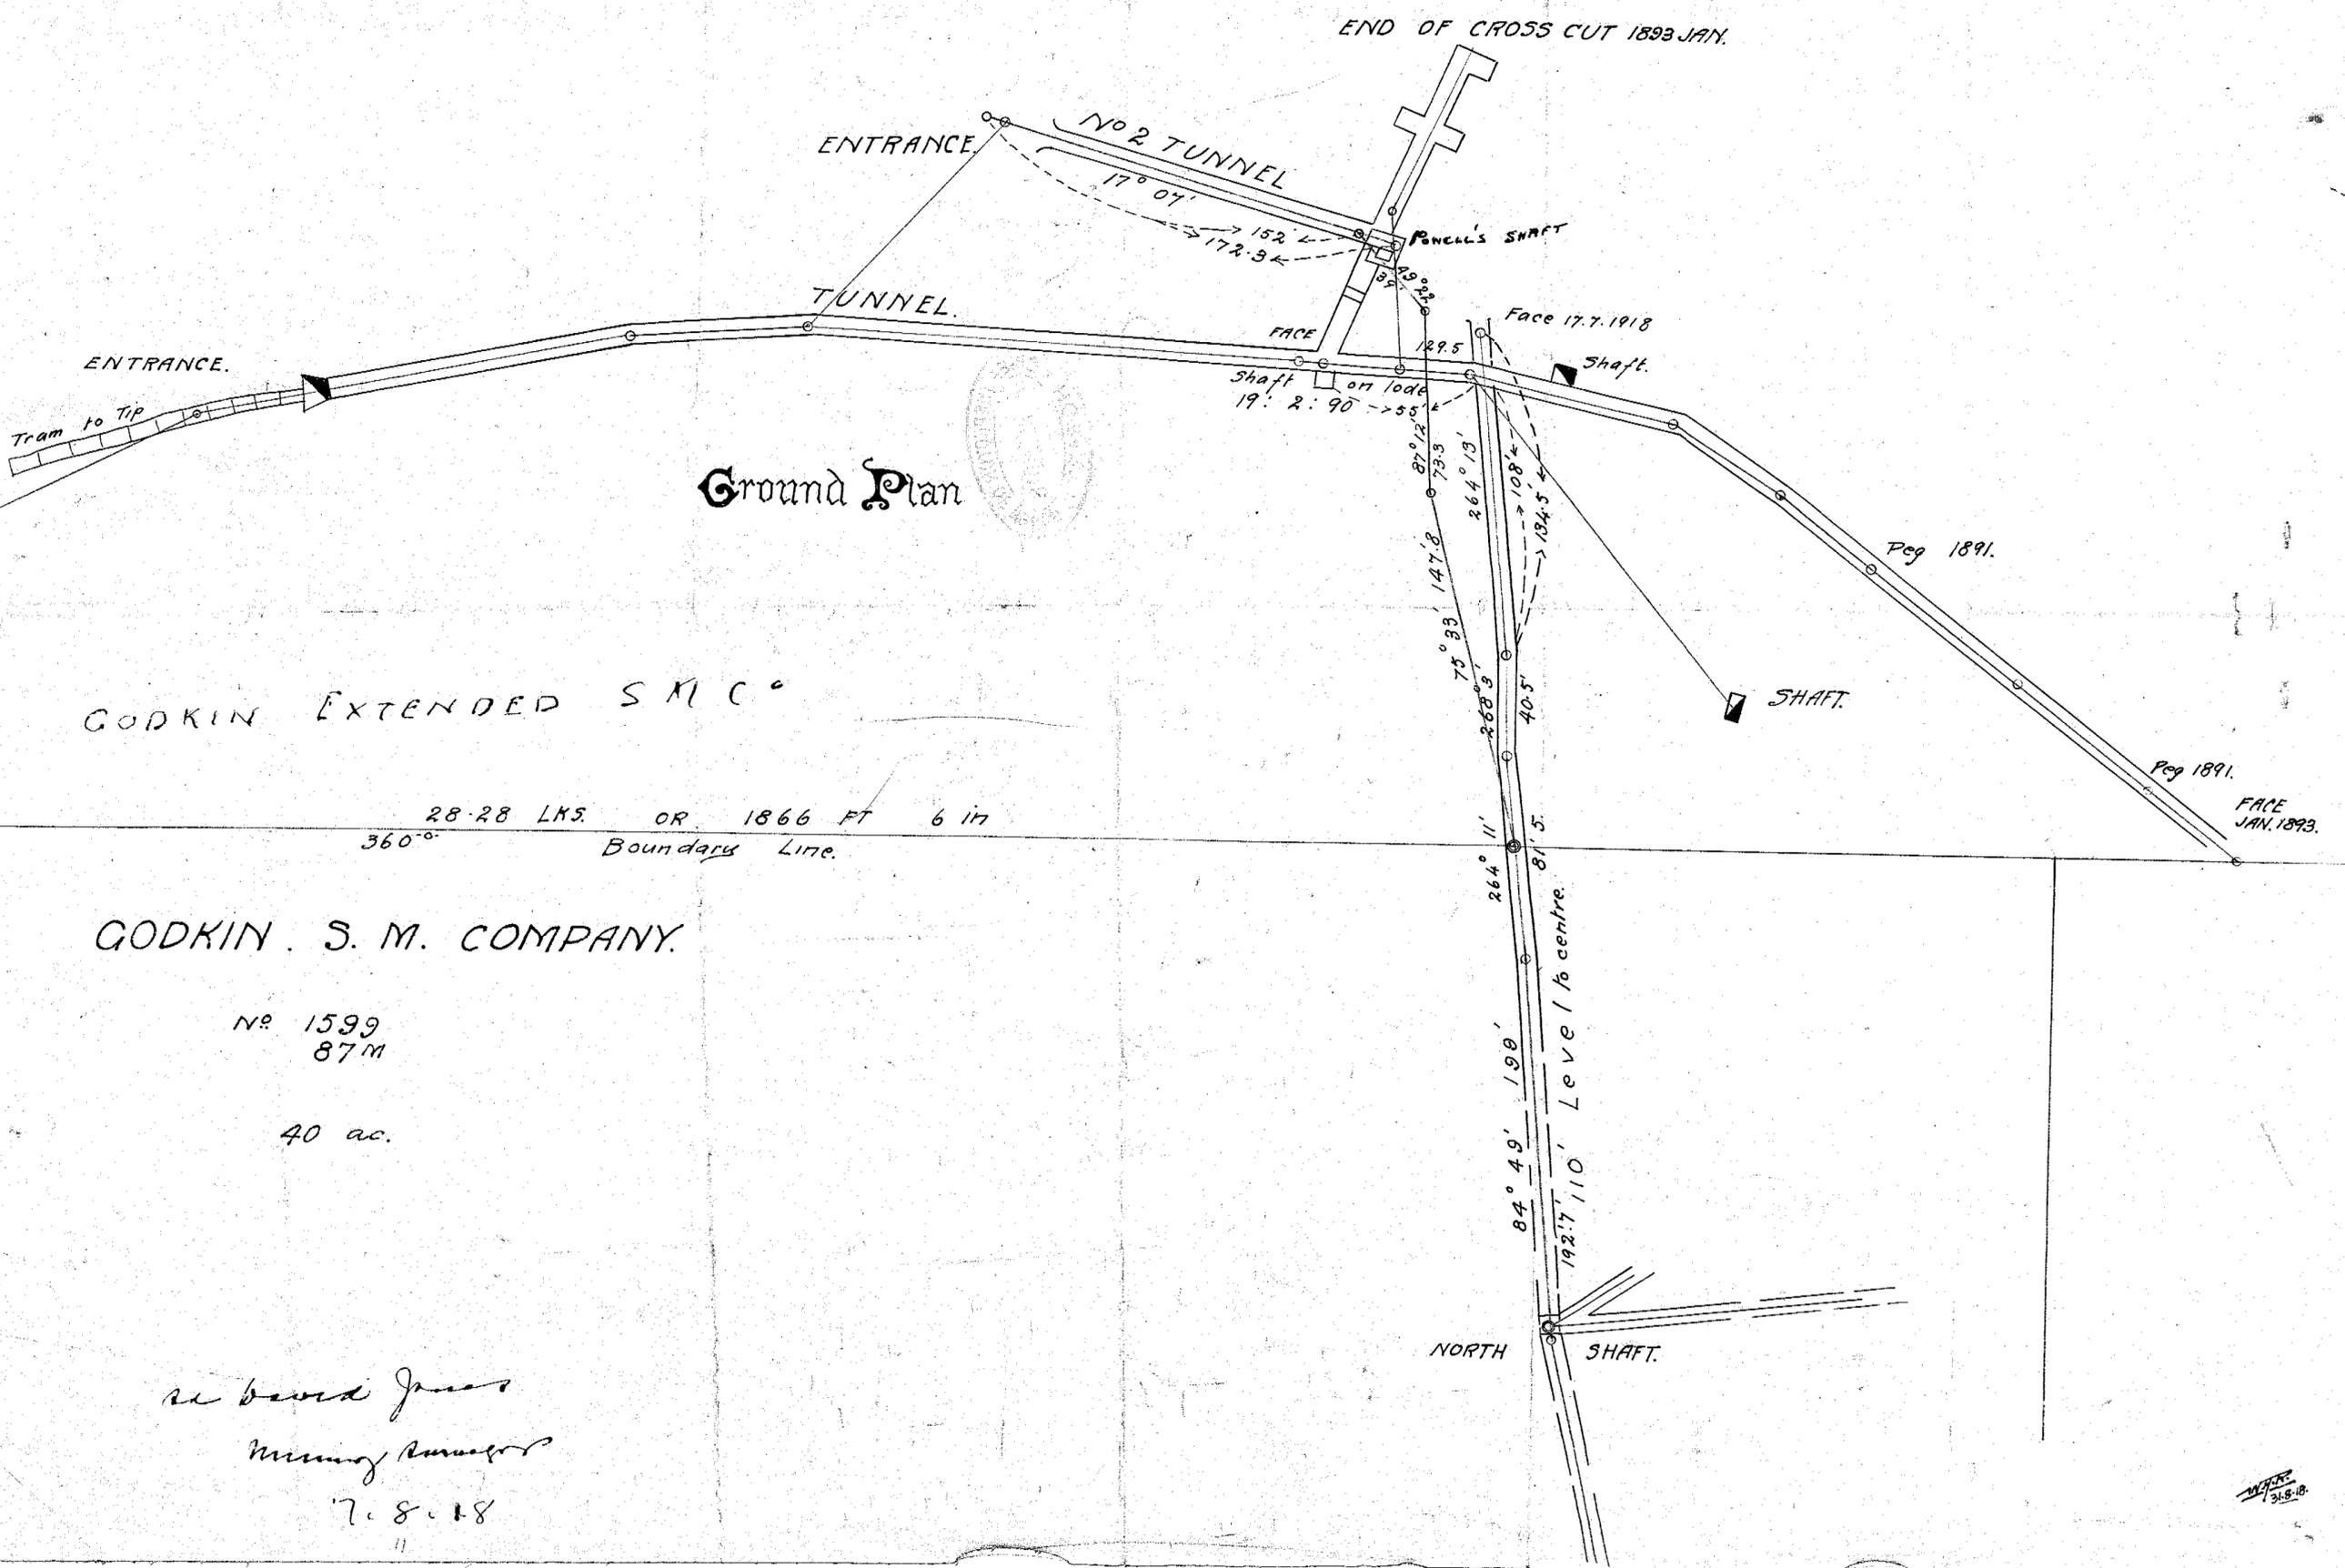

Ground Plan

GODKIN EXTENDED S.M.C.

28.28 LKS. OR 1866 FT 6 IN
360° Boundary Line.

GODKIN S.M. COMPANY.

No 1599
87 M

40 ac.

re David Jones
Mining Manager
7.8.18

W.A.C. 318-18