
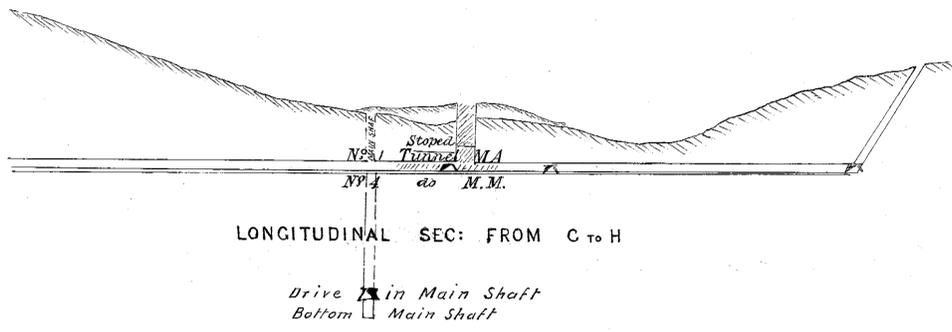


CODKIN S.M. COMPANY'S

Underground Works

WHYTE RIVER

Scale 50 Feet to 1 Inch

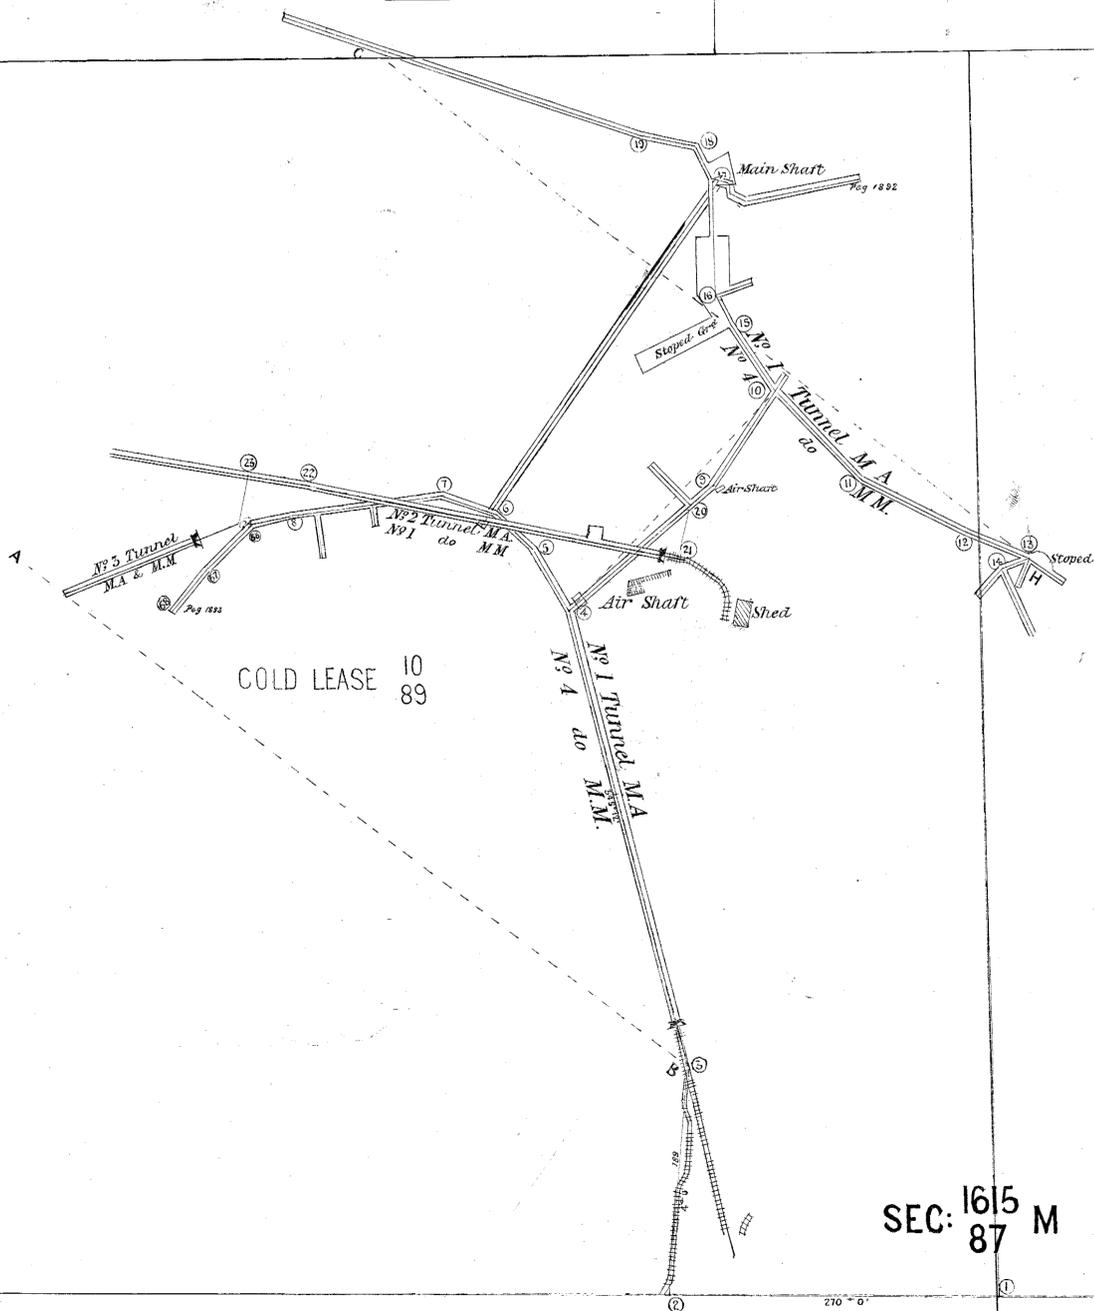

Lamin Jones
Miner
Jan 18 93.

50 Feet

50-991

50-991