


166-07

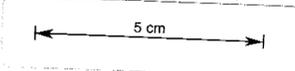

H.P.S.

(N)

# PLAN



OF THE

## GODKIN S. M. COMPANY'S

Underground Works

## WHYTE RIVER

Scale 50 Feet to 1 Inch

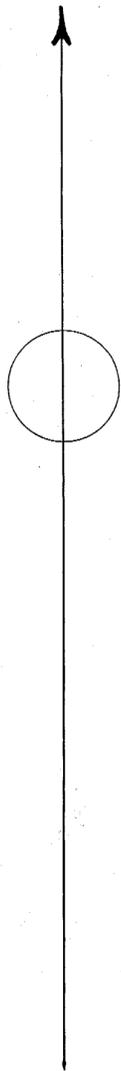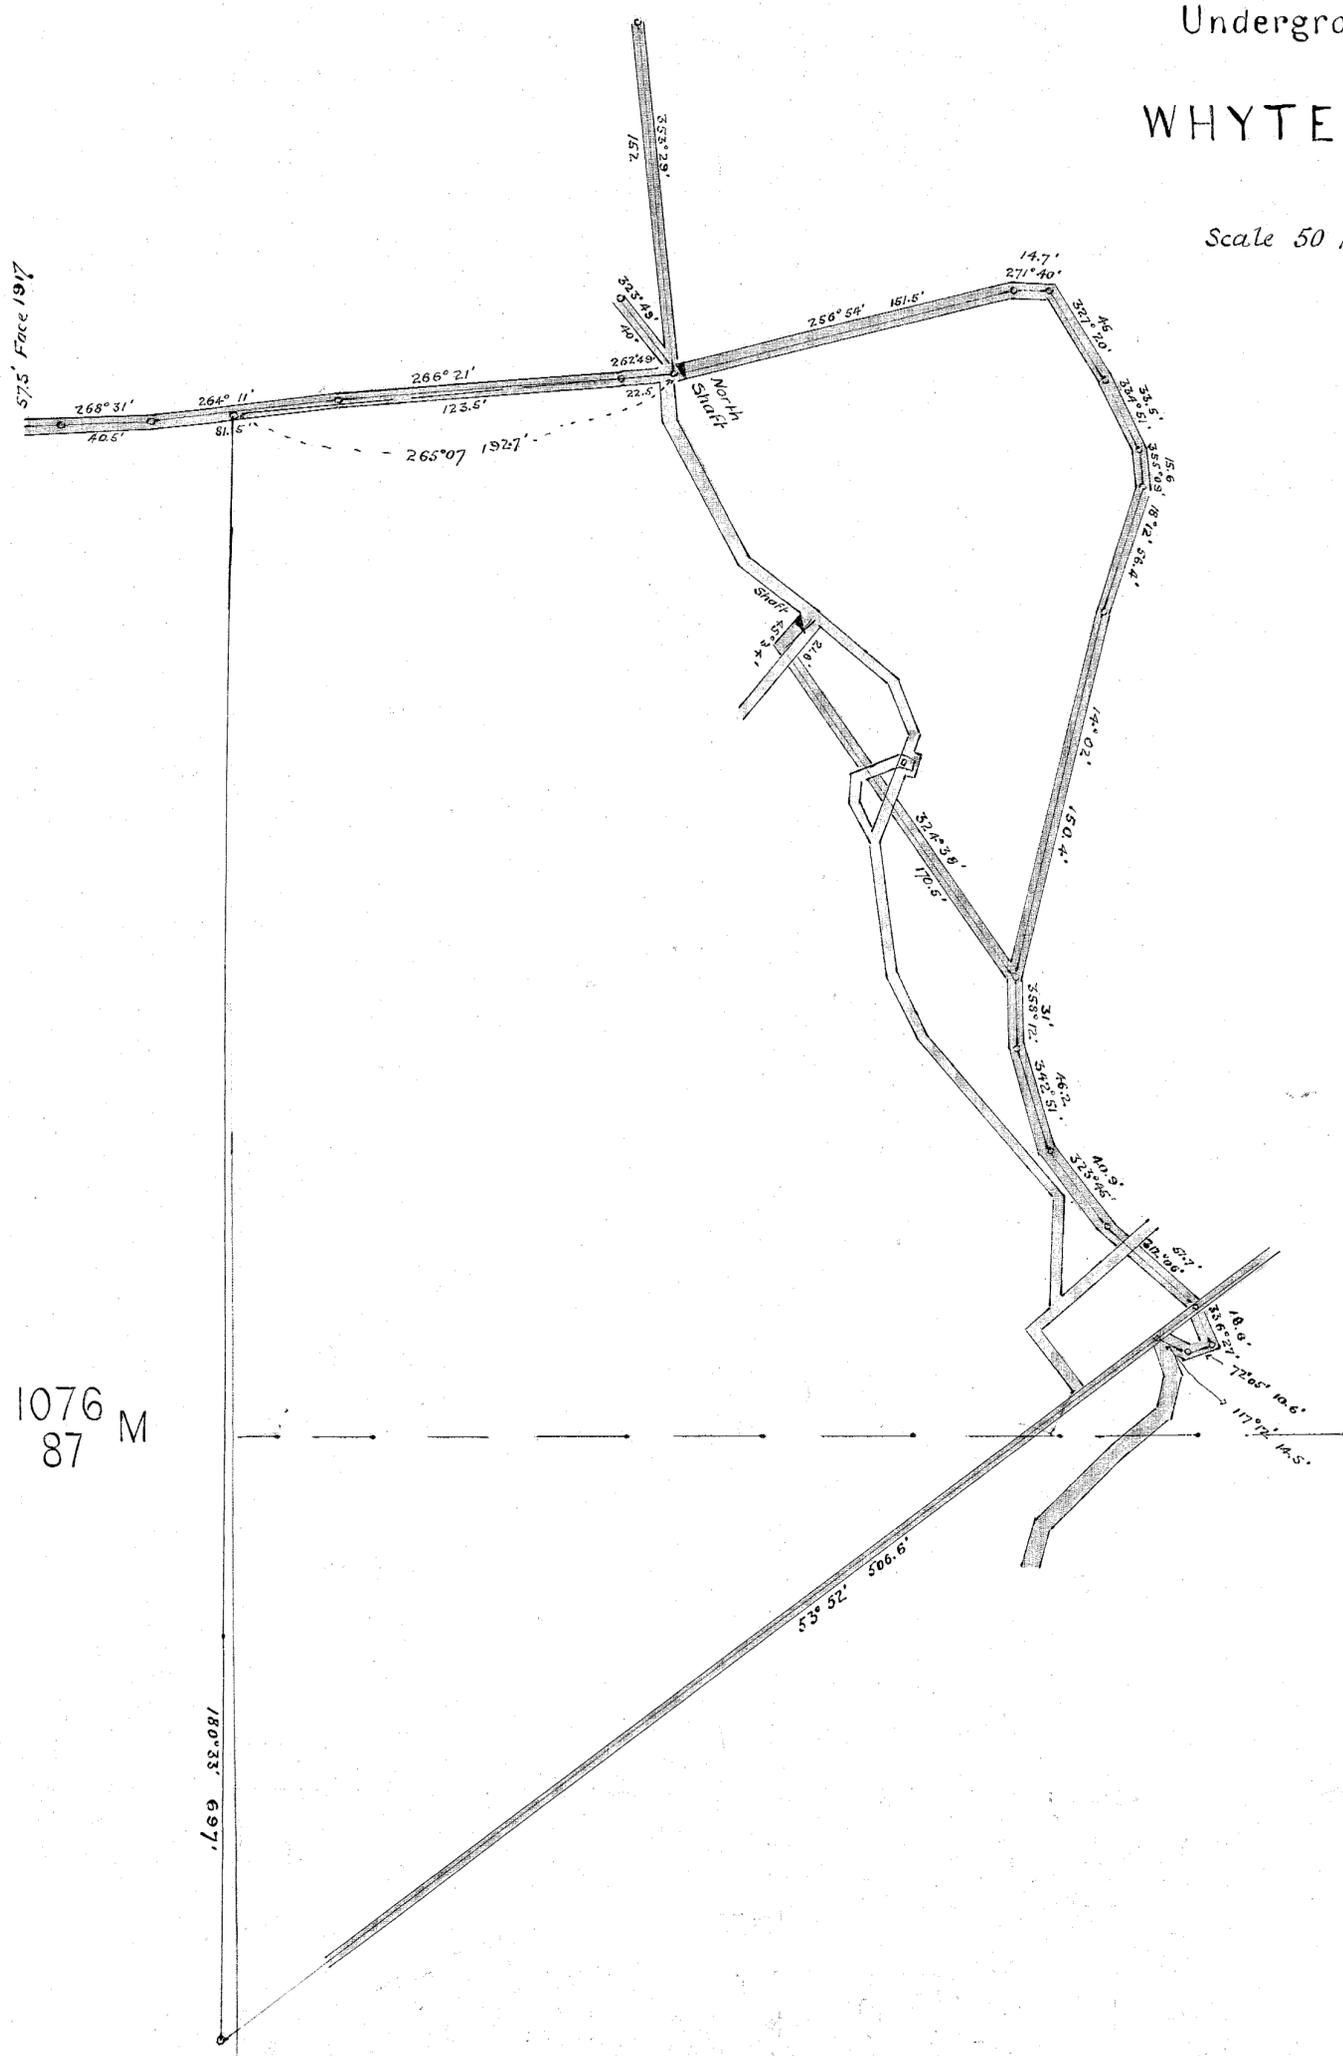

1076  
87 M

SEC: 1599  
87 M

*David Jones  
Dist Surveyor  
Hobart - Tasmania.*

*12.7.17*