
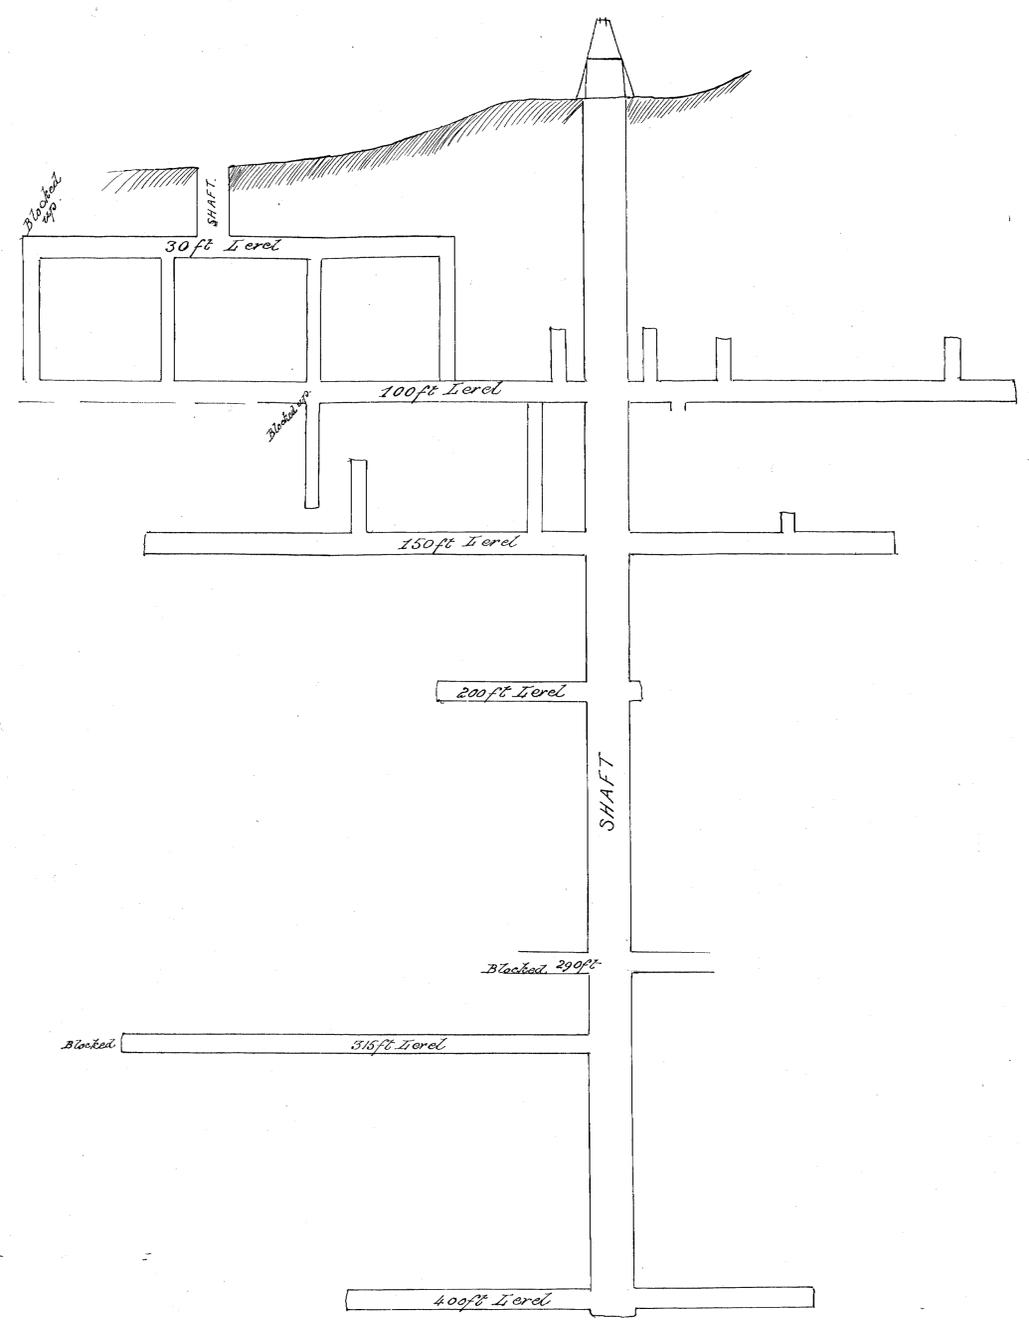


AMAL^{GTD} WEST TASMANIA G.M.

Scale 100 feet to 4 inches

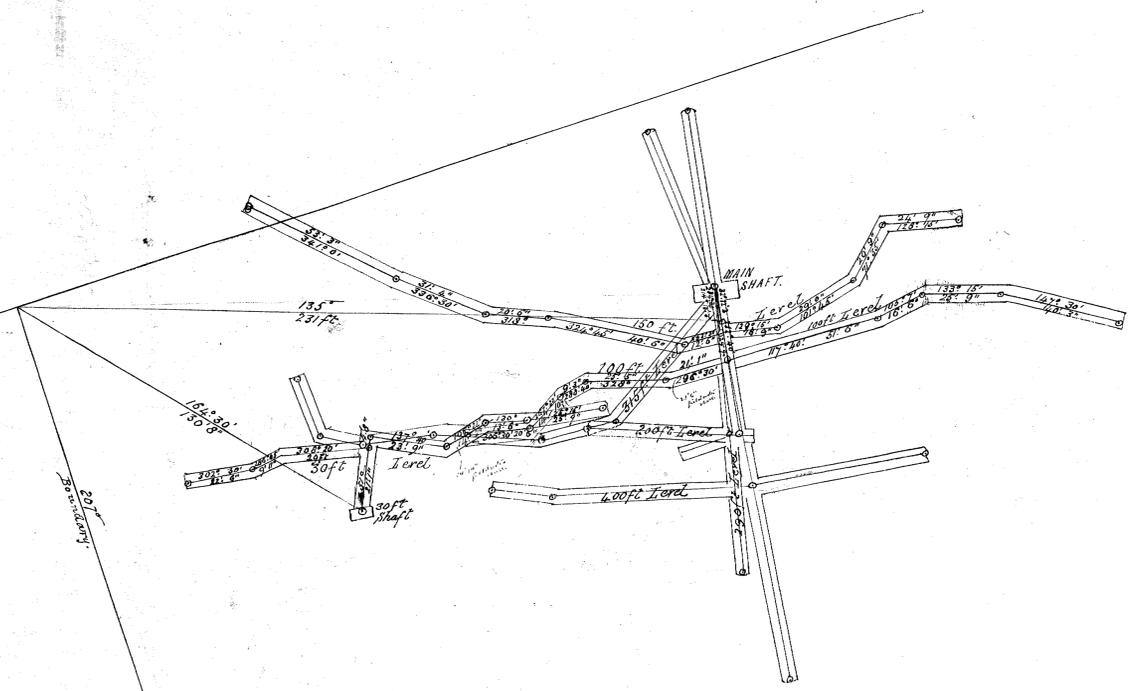

I hereby certify that this
 is a correct copy of plan of
 workings as far as can be obtained
 up to end of year 1887-1891
 C. Pringle Waterhouse
 Mining Engineer

108

500

108

108