
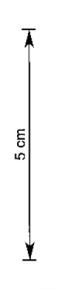


# AMAL <sup>STP</sup> WEST TASMANIA G.M.

Scale 100ft to 4 inches

## CROSS SECTION.

168-02

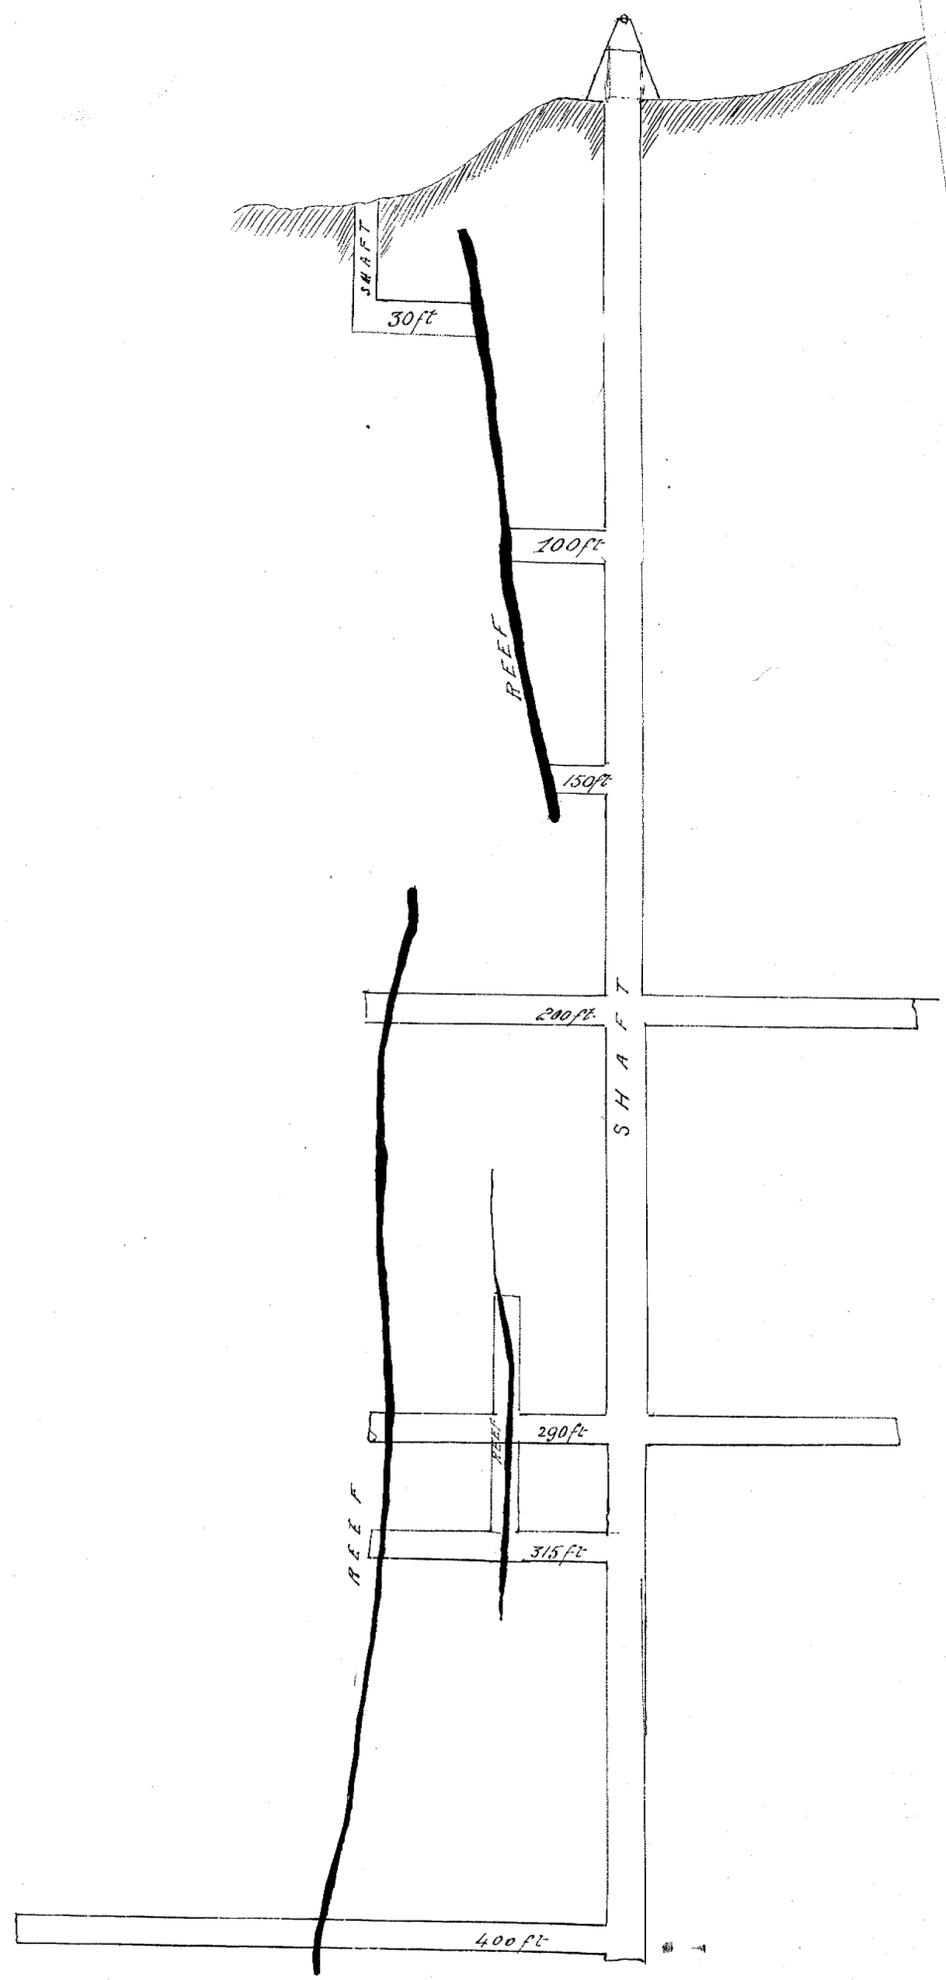

168-02

Verified correct copy of  
 Cross section of West Tasmania  
 G.M. Co. *W. B. W. W.*  
*W. B. W. W.*  
*W. B. W. W.*

145