


PLAN


AMALG T^{LD}. WEST TASMANIA G.M.

Scale 25ft. to 1 inch.

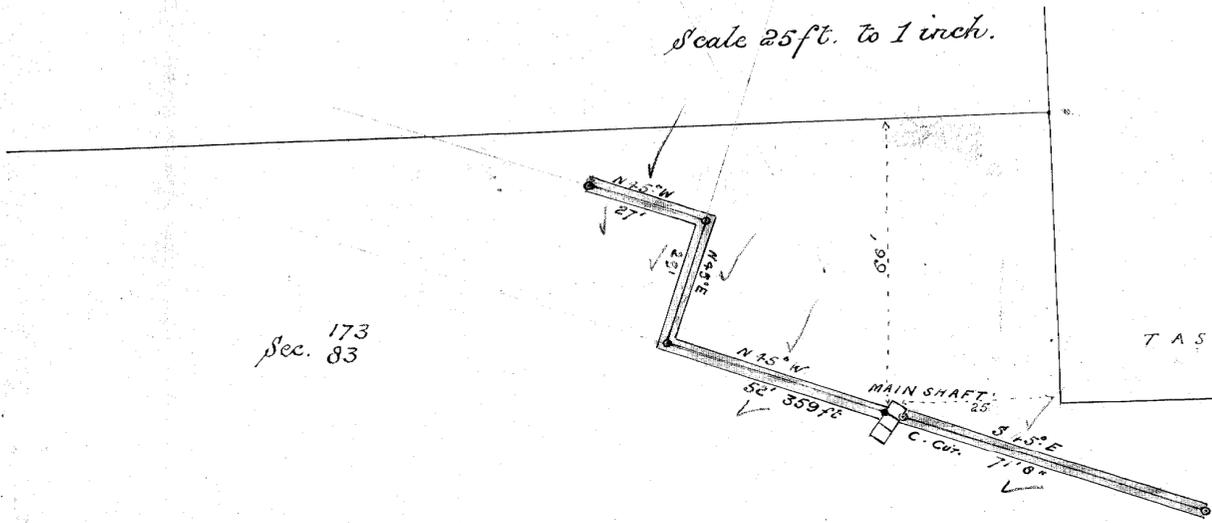

173
Sec. 83

TASMANIA G.M.

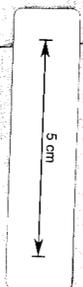

*Chambers & Co. Tasmanian
1891*

168-03

*Certified correct copy of plan
made from manuscript notes
checked with compass.
C. Bailey Waterhouse
1878/1880*

copy submitted Aug 11 1880

168-03