


17


CODKIN EXTENDED SILVER MINE WHYTE RIVER

Scale 50 Feet to one Inch

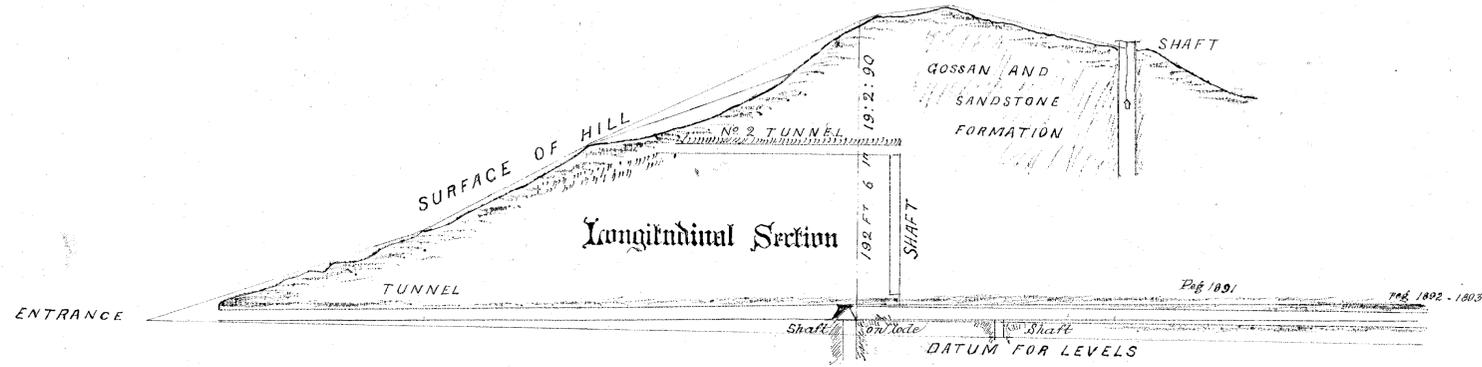

Nº 1076
87M

80 ac

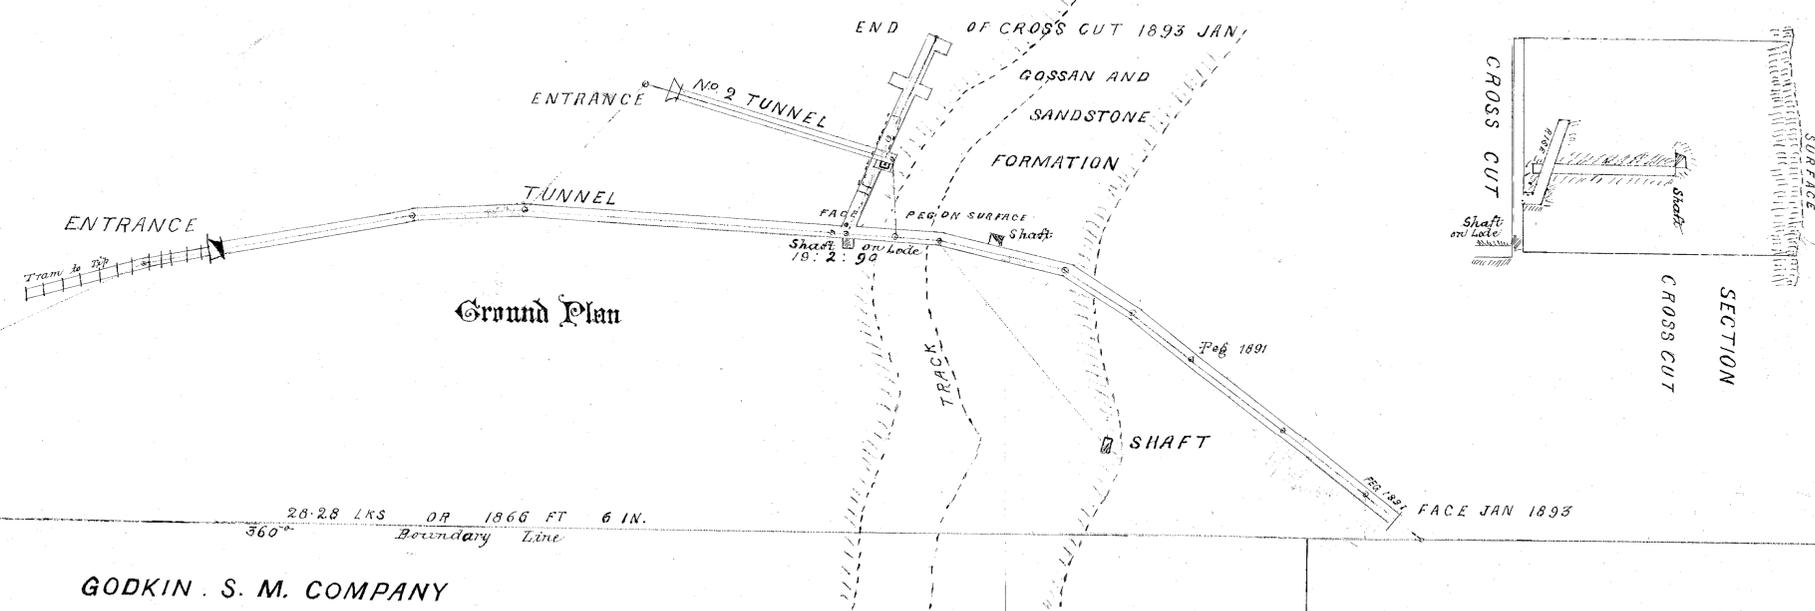

Ground Plan

26-28 LKS OR 1866 FT 6 IN.
360° Boundary Line

GODKIN . S . M . COMPANY

Nº 1599
87M

40 ac

Nº 1712
87M

40 ac

Waratah

January 1893

David Jones

District Surveyor

169-01

5 cm

Nº 916
87M

40 ac

J. SMITH

LESSEE

Nº 165
87M

40 ac