
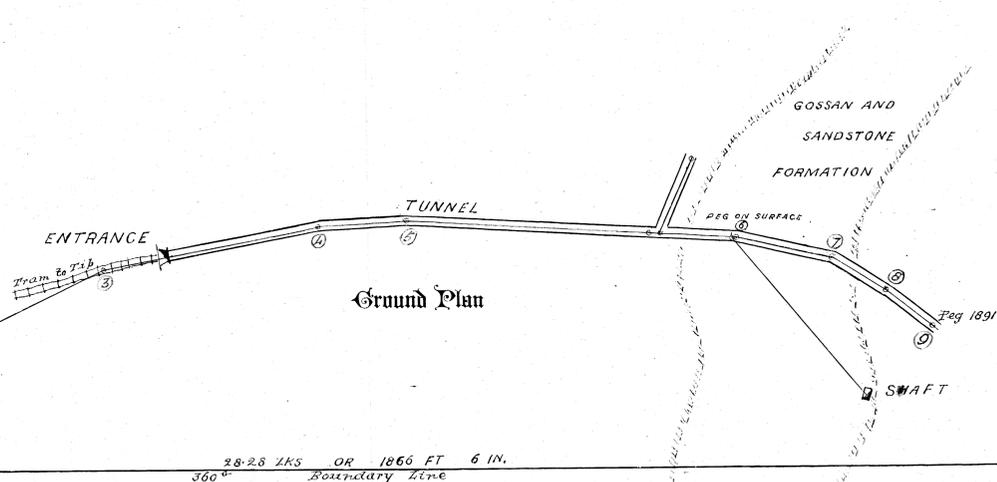


13

**PLAN
&
SECTION**
GODKIN EXTENDED SILVER MINE
WHYTE RIVER.

Scale 50 Feet to one Inch

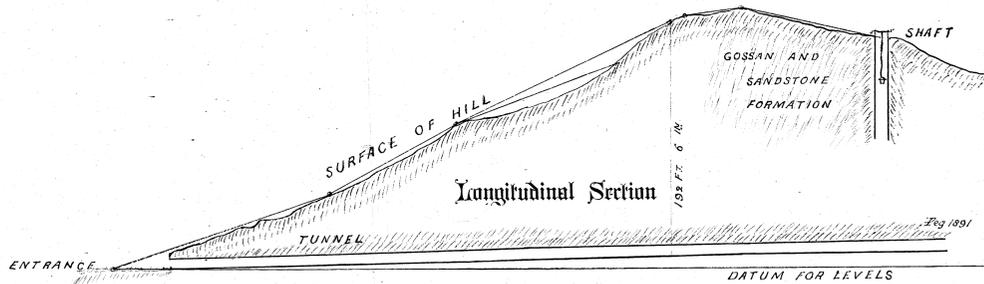

1779
87M
80 ac

Nr 1076
87M
80 ac

Nr 916
87M
40 ac
J. SMITH
LESSEE

Nr 1856
87M
40 ac


GODKIN S. M. COMPANY.

Nr 1899
87M
40 ac

Nr 1712
87M
40 ac

Waratah
February 1897
David Jones,
District Surveyor.

169-2

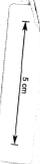

169-2