
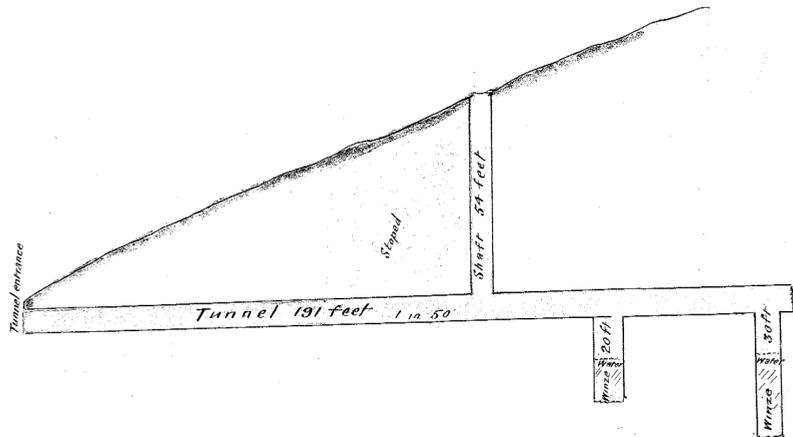


Workings on N<sup>o</sup> 249 Jubilee G.M. Co

County of Cornwall, near Malthinna

Scale 25 feet to an inch

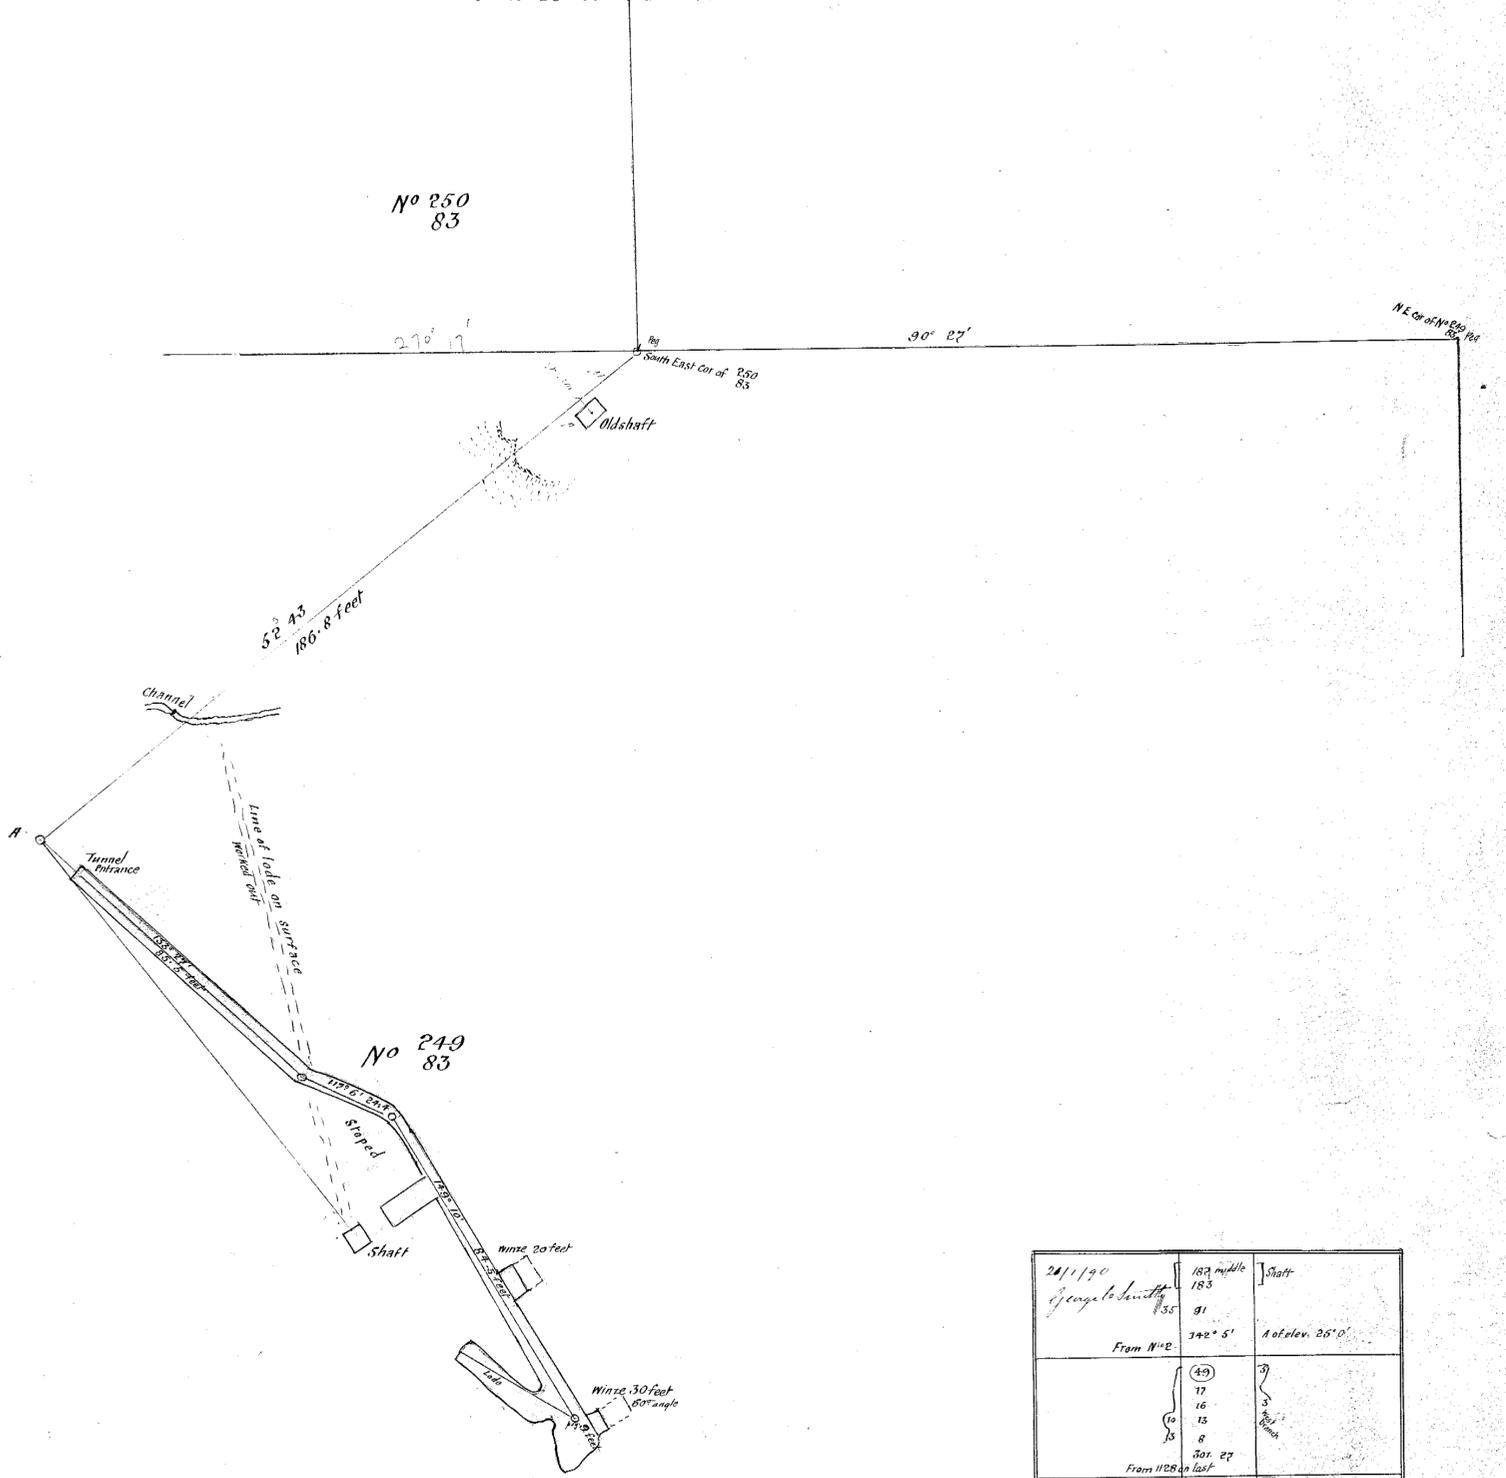

241/190	187 middle	Shaft
George Smith	183	
	91	
From N <sup>o</sup> 2	342° 5'	Not elev. 26° 0'
	17	Shaft
	16	
	15	
	8	
	201 27	
From 1128 on last	141	Shaft
	137	
	129	
angle down 60°	(128) mark	
	79	
	68	
	65	
	36	
	53	
	25	
	19-3° 10'	
	(32)	Shaft
	29	
	137° 6'	
	(129)	
	18	
	(2)	155° 22'
	(283)	Channel
	216	
	200	
	64	
	53	
	24	
	232° 43'	
	250	
	83	

(Survey made with theodolite)  
Malthinna, beginning at S. E. cor of N<sup>o</sup> 250 Jubilee G.  
Survey of Workings on N<sup>o</sup> 249 Jubilee G.M. Co near

30th January 1890  
George Smith

170-01

170-01