
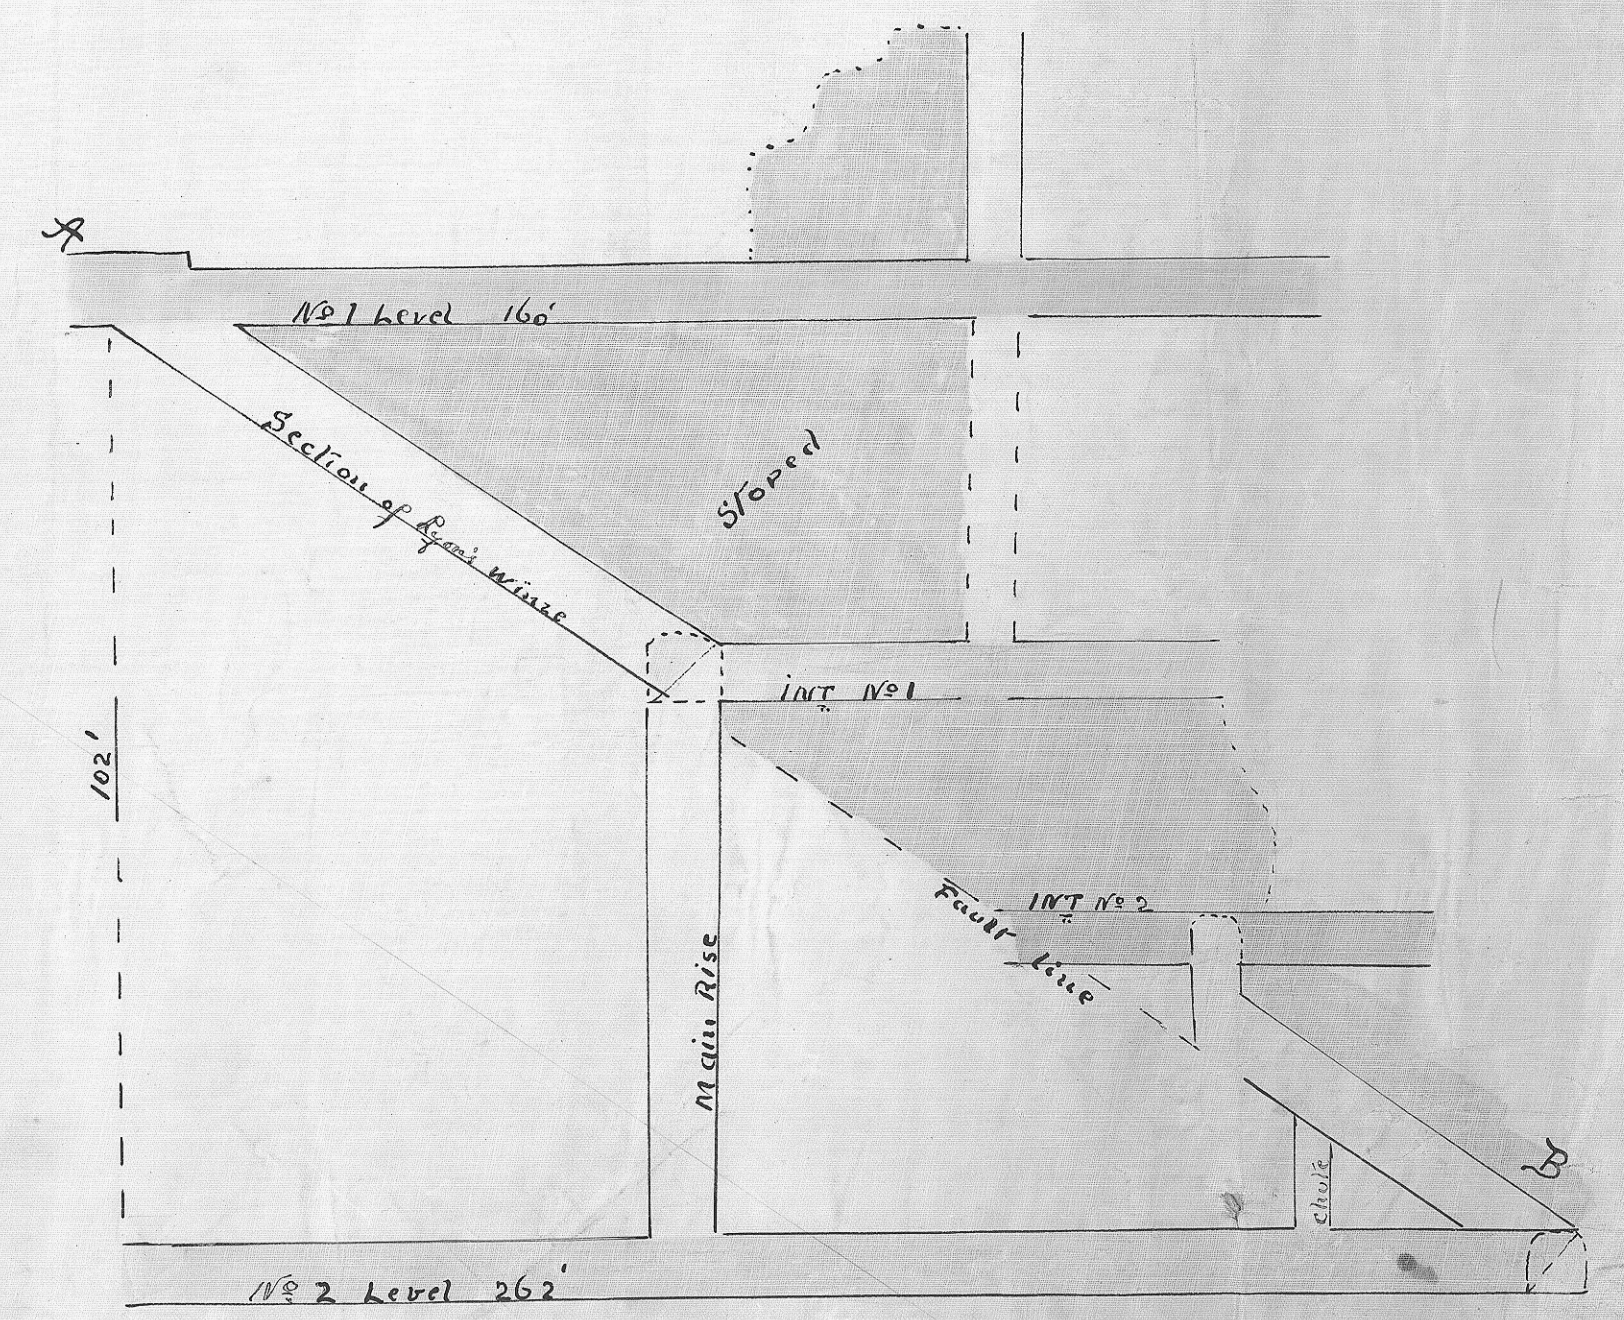
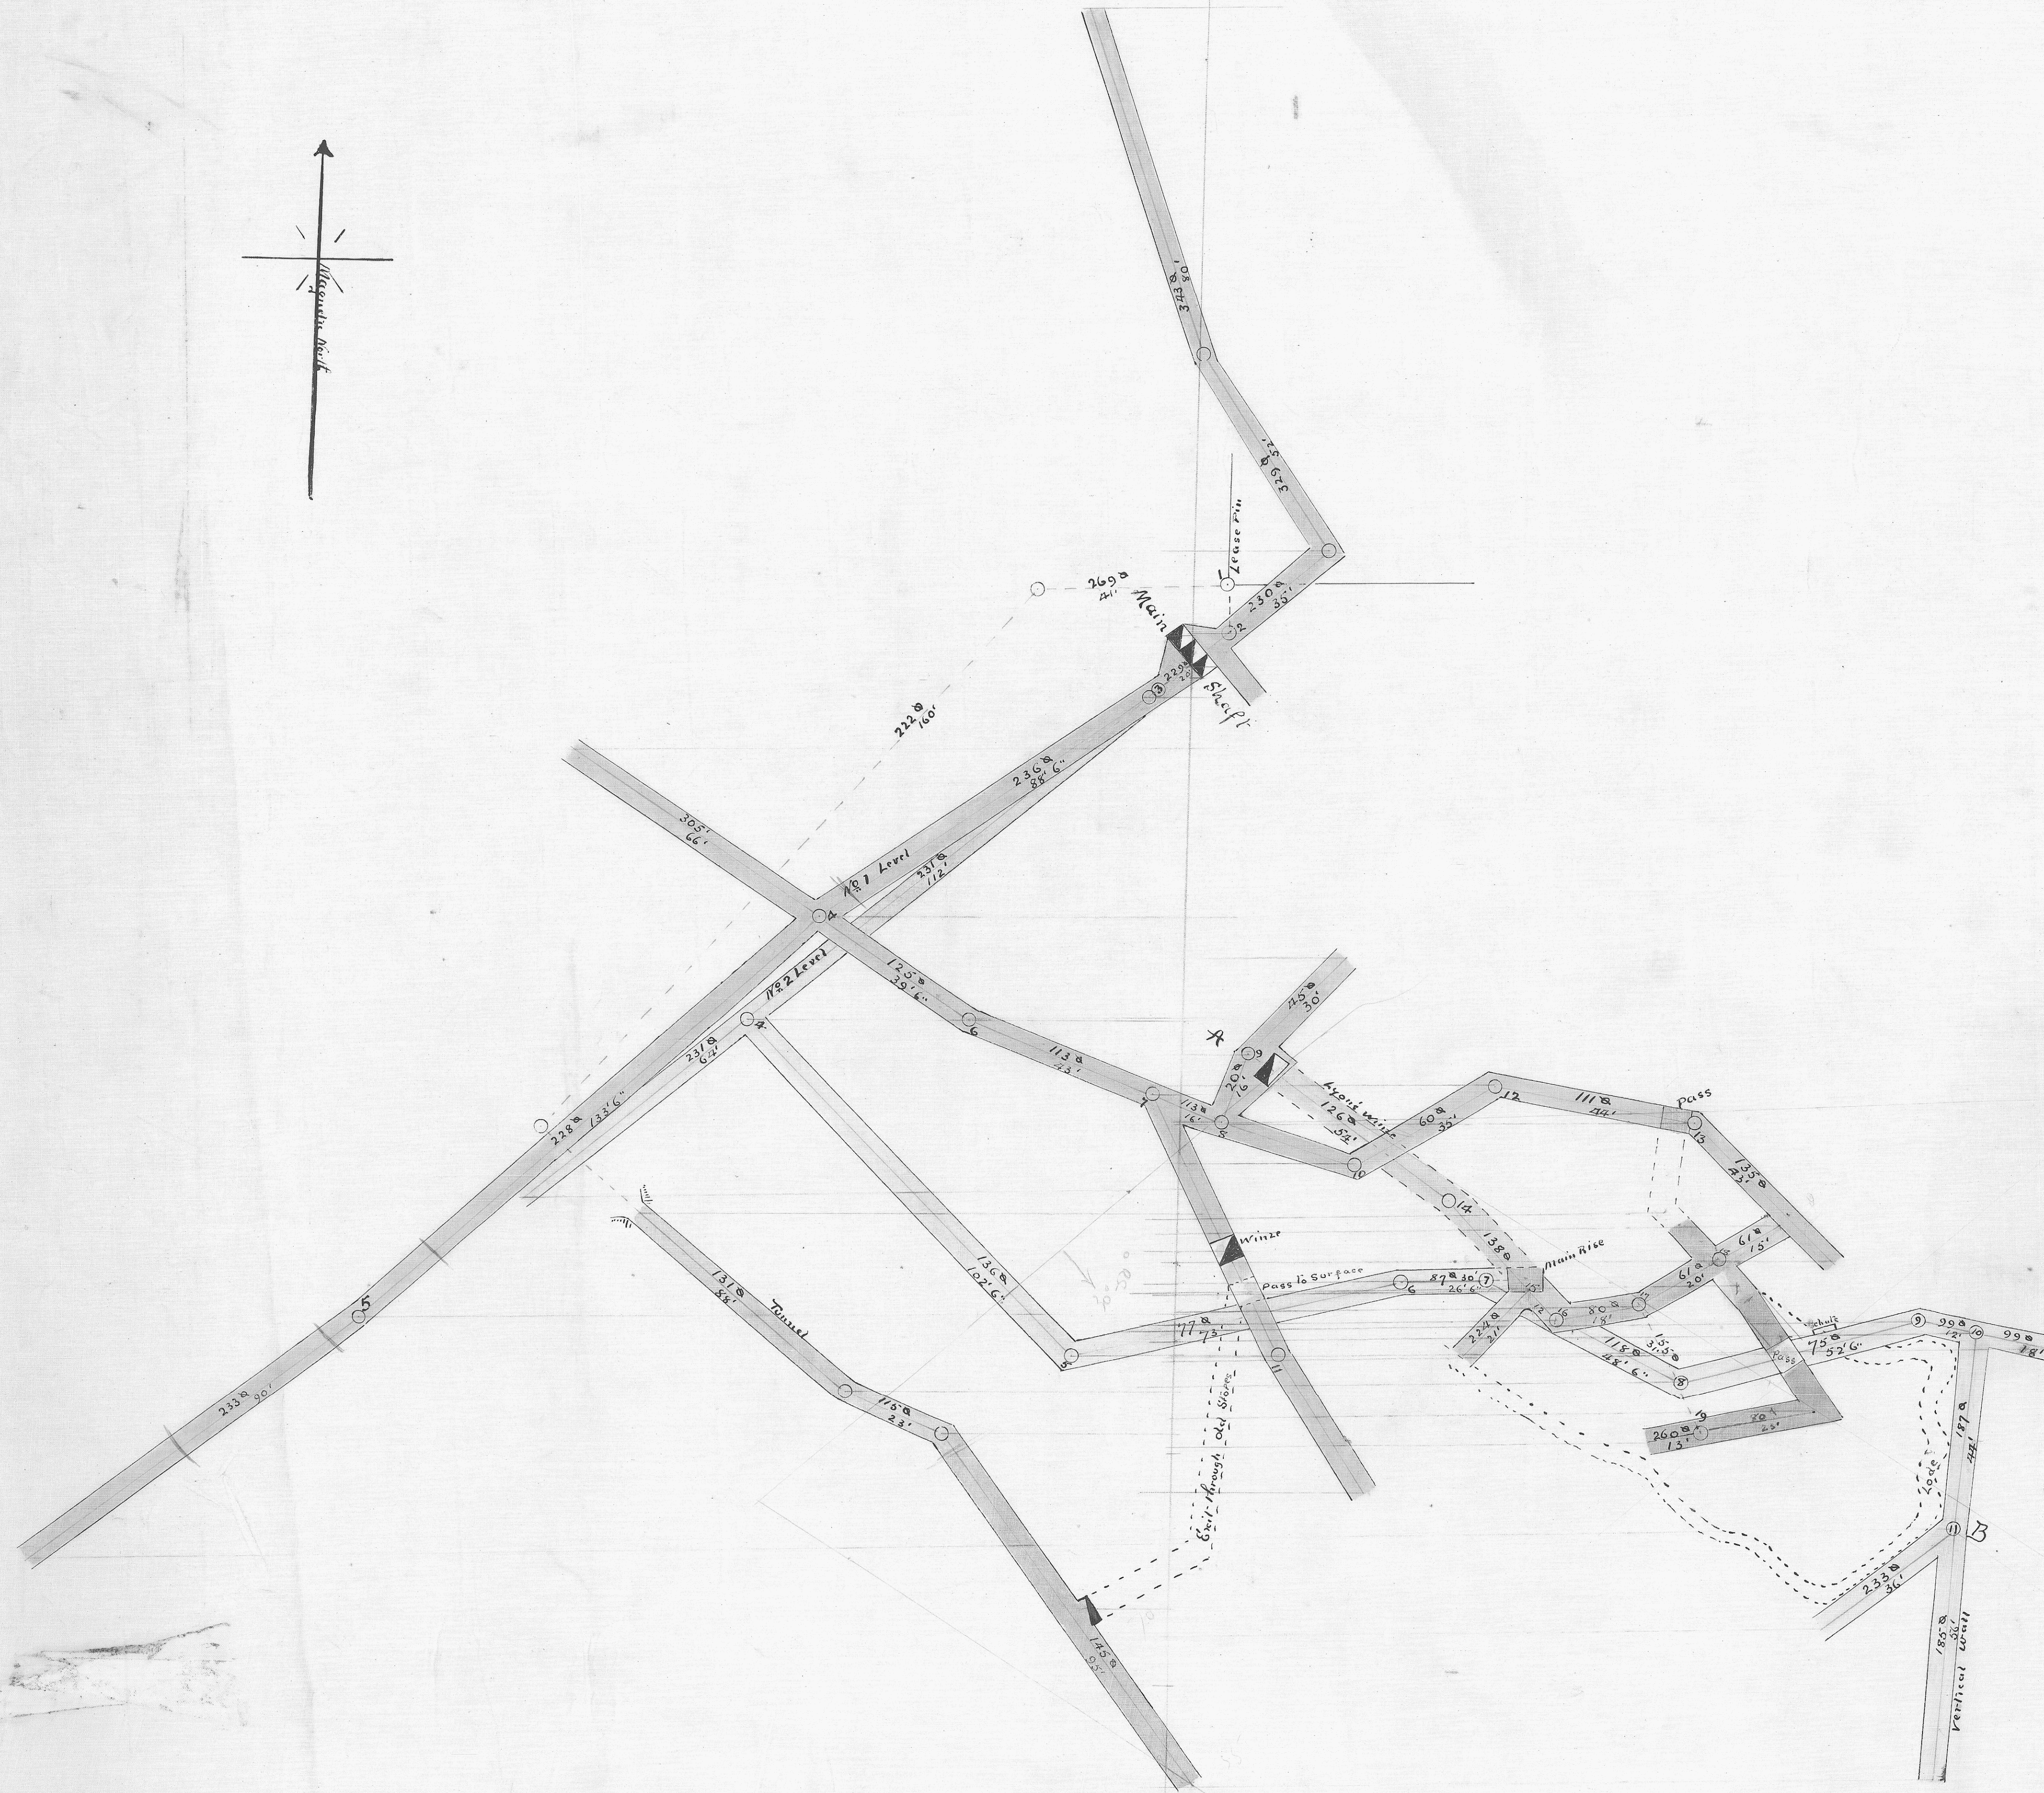


PLAN NEW LUBILEE

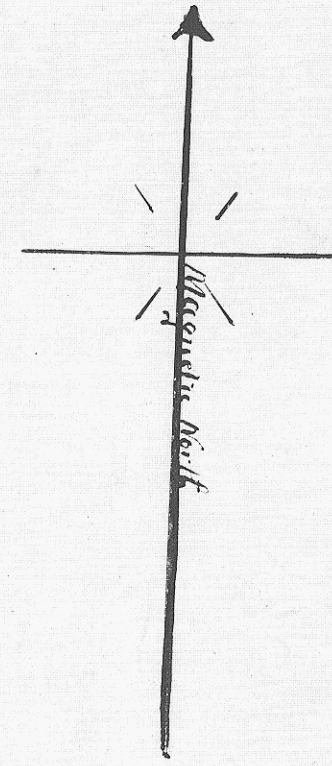

Scale 20' = 1 inch

Indurment used
by 2500 ft
from surface
170-03

5 cm

170-03