
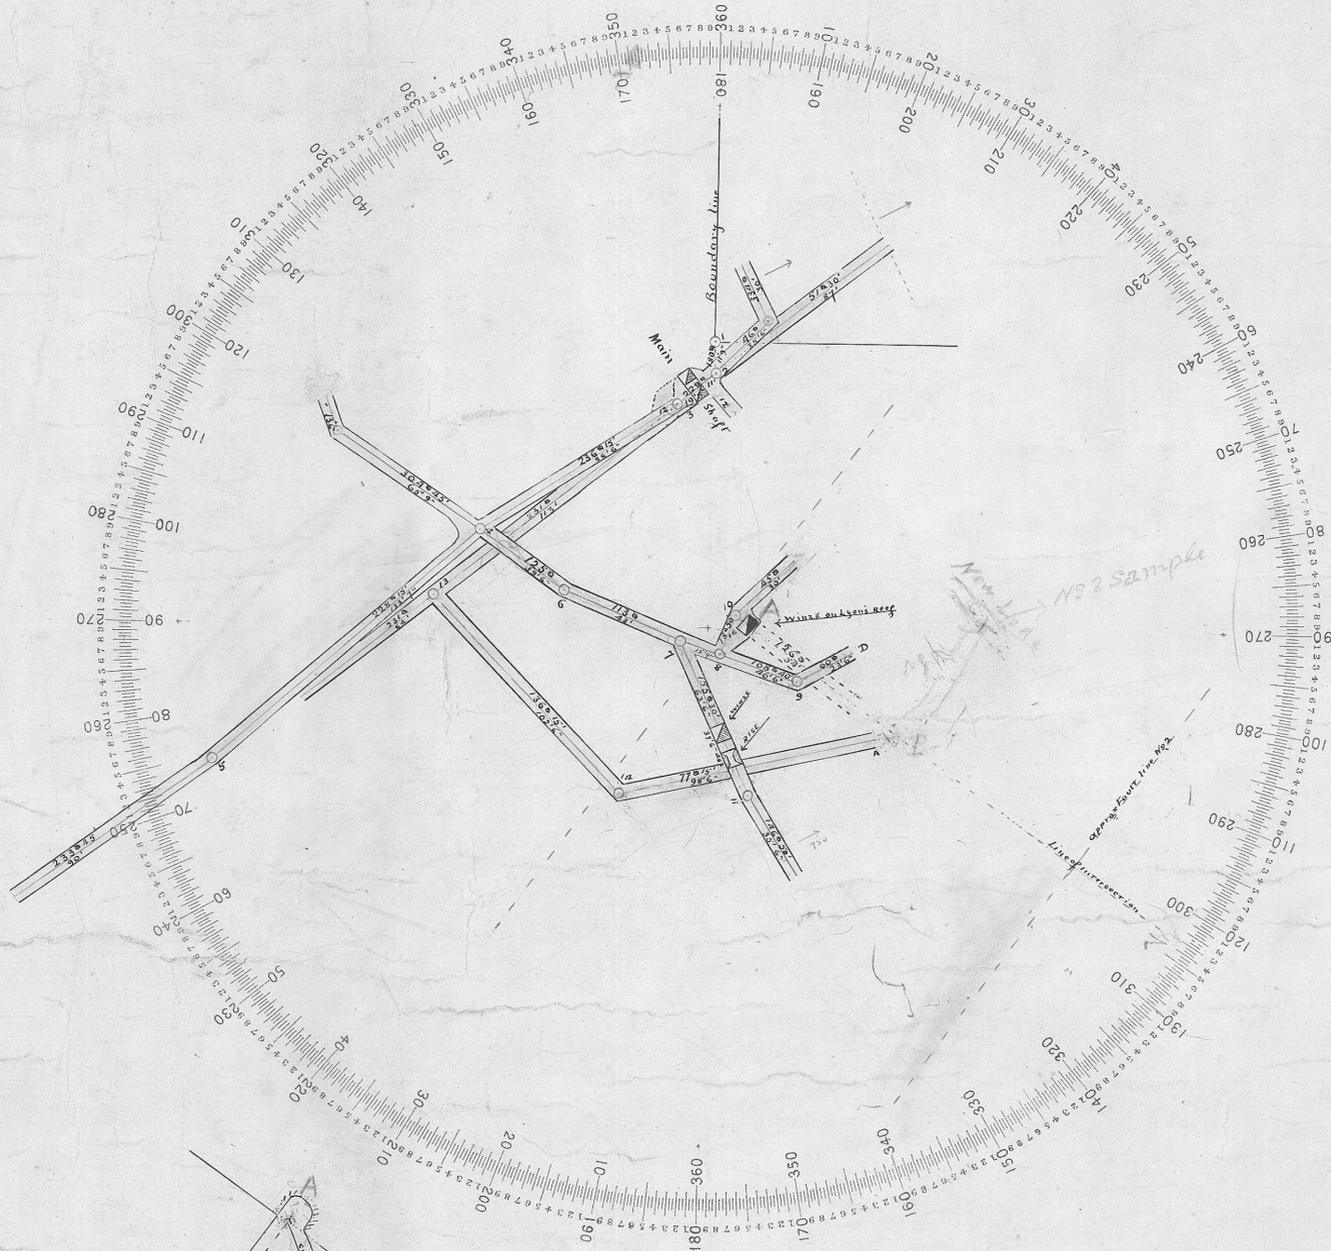


PLAN New Jubilee Gold Mine Scale 40' = 1 inch

5 cm

170-07

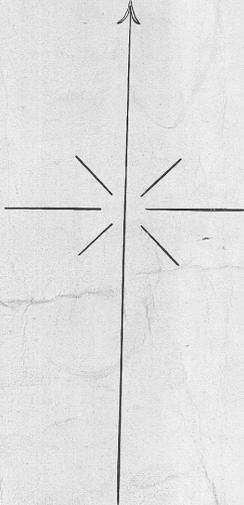

Indicated level of New Jubilee (Frythor & Sons)
2 1/2 x 3 1/2 1914
C. W. Brennan

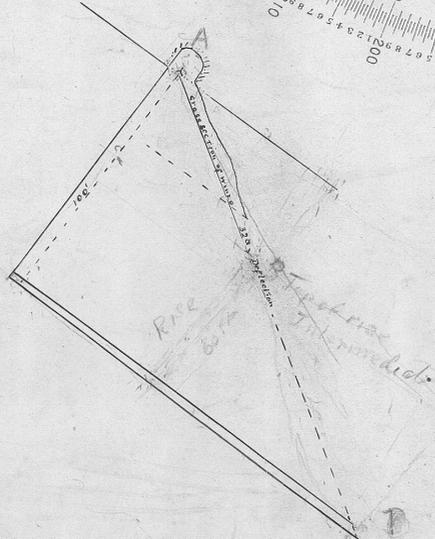


Plate 10

from Mr. Brennan
170-07
260

No. 1 Level 160'
No. 2 Level 260'