

887 40 AC
87M

44 20 AC
87M




1653 20 AC
87 M

1000 80 AC
87M

180° Boundary Line
1415 LKS

360° Boundary Line
1414 LKS Datum of Survey

1414 LKS
Boundary Line 90°

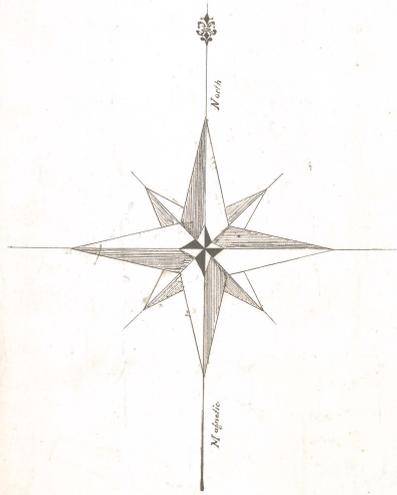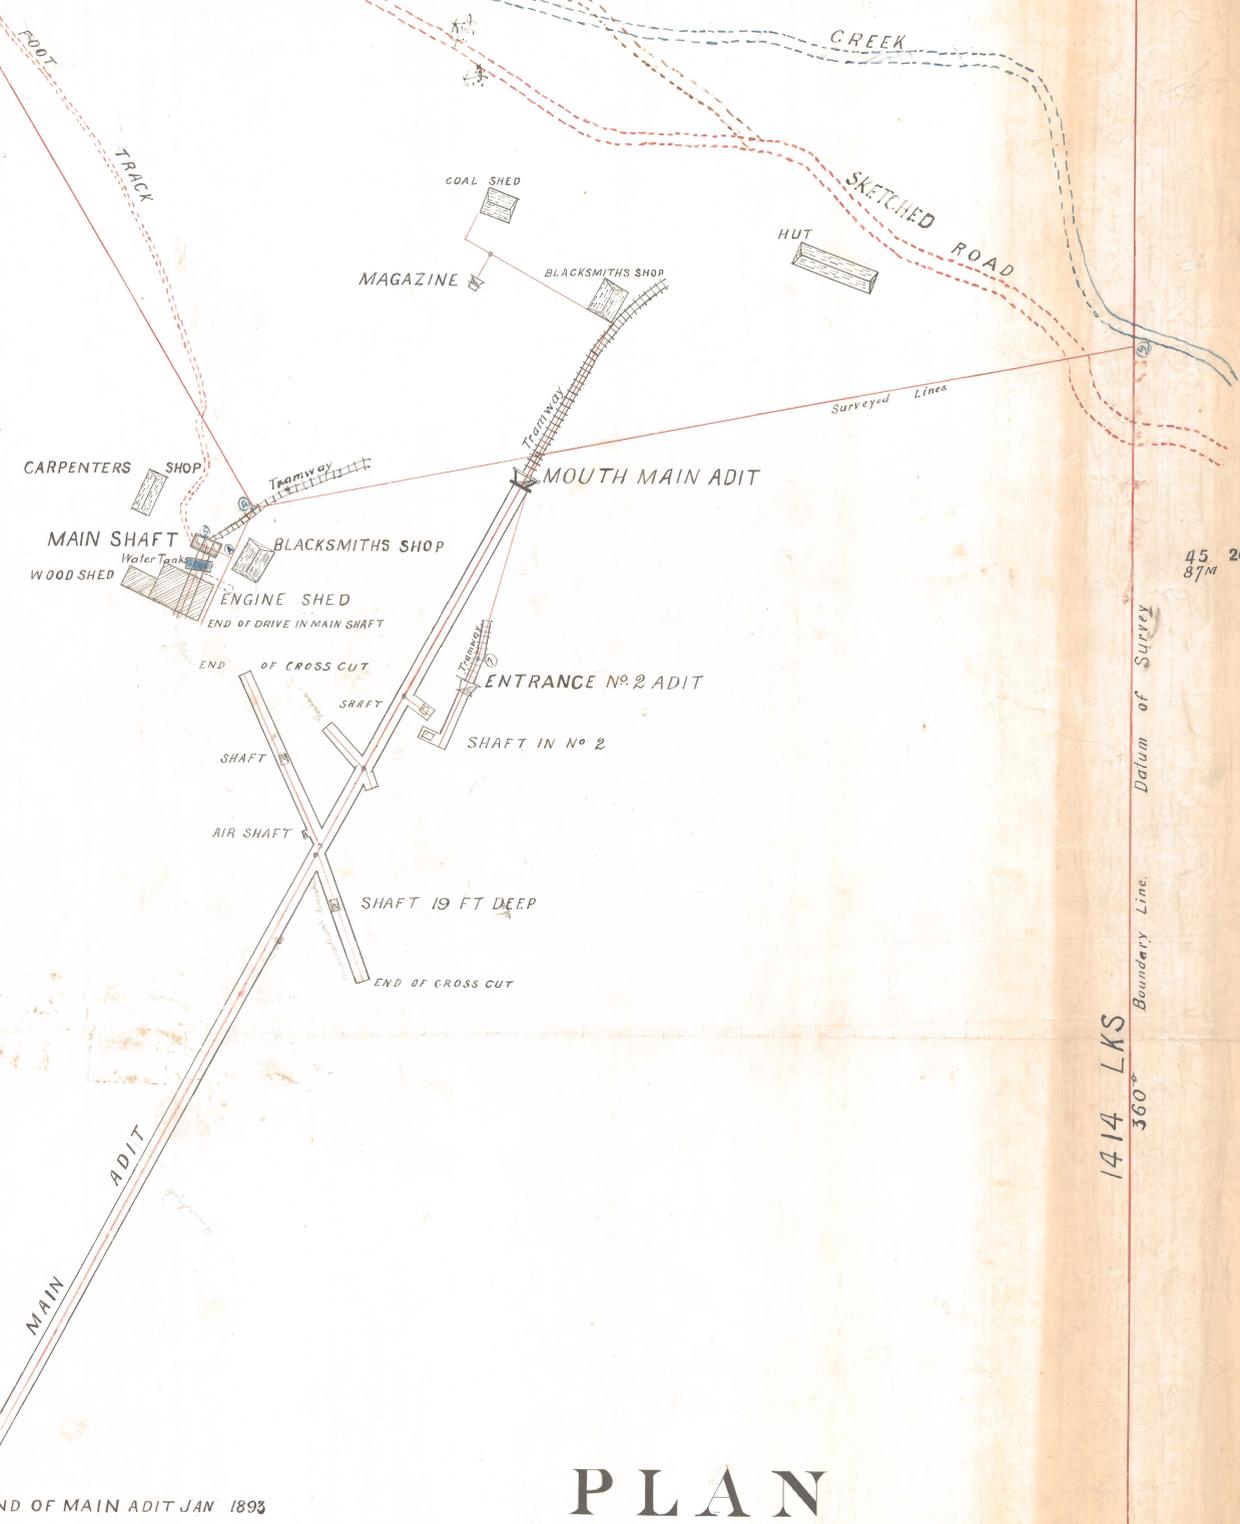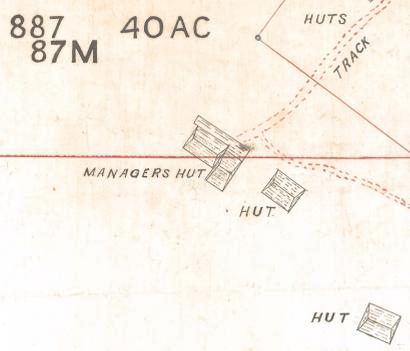

Surveyed in accordance with
Regulation of Mines Act 1881 and 1884
Warratah Feb 20th 1893

W. J. J. J.
District Surveyor

PLAN
of
BELLS REWARD S. M. Cos MINE
Scale 25 feet to one Inch

171-01