


171-02

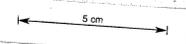


171-01  
TOO LARGE

171-02

# SECTION of BELLS REWARD S. M. CO'S MINE

Scale 25 feet to one Inch

## 1893

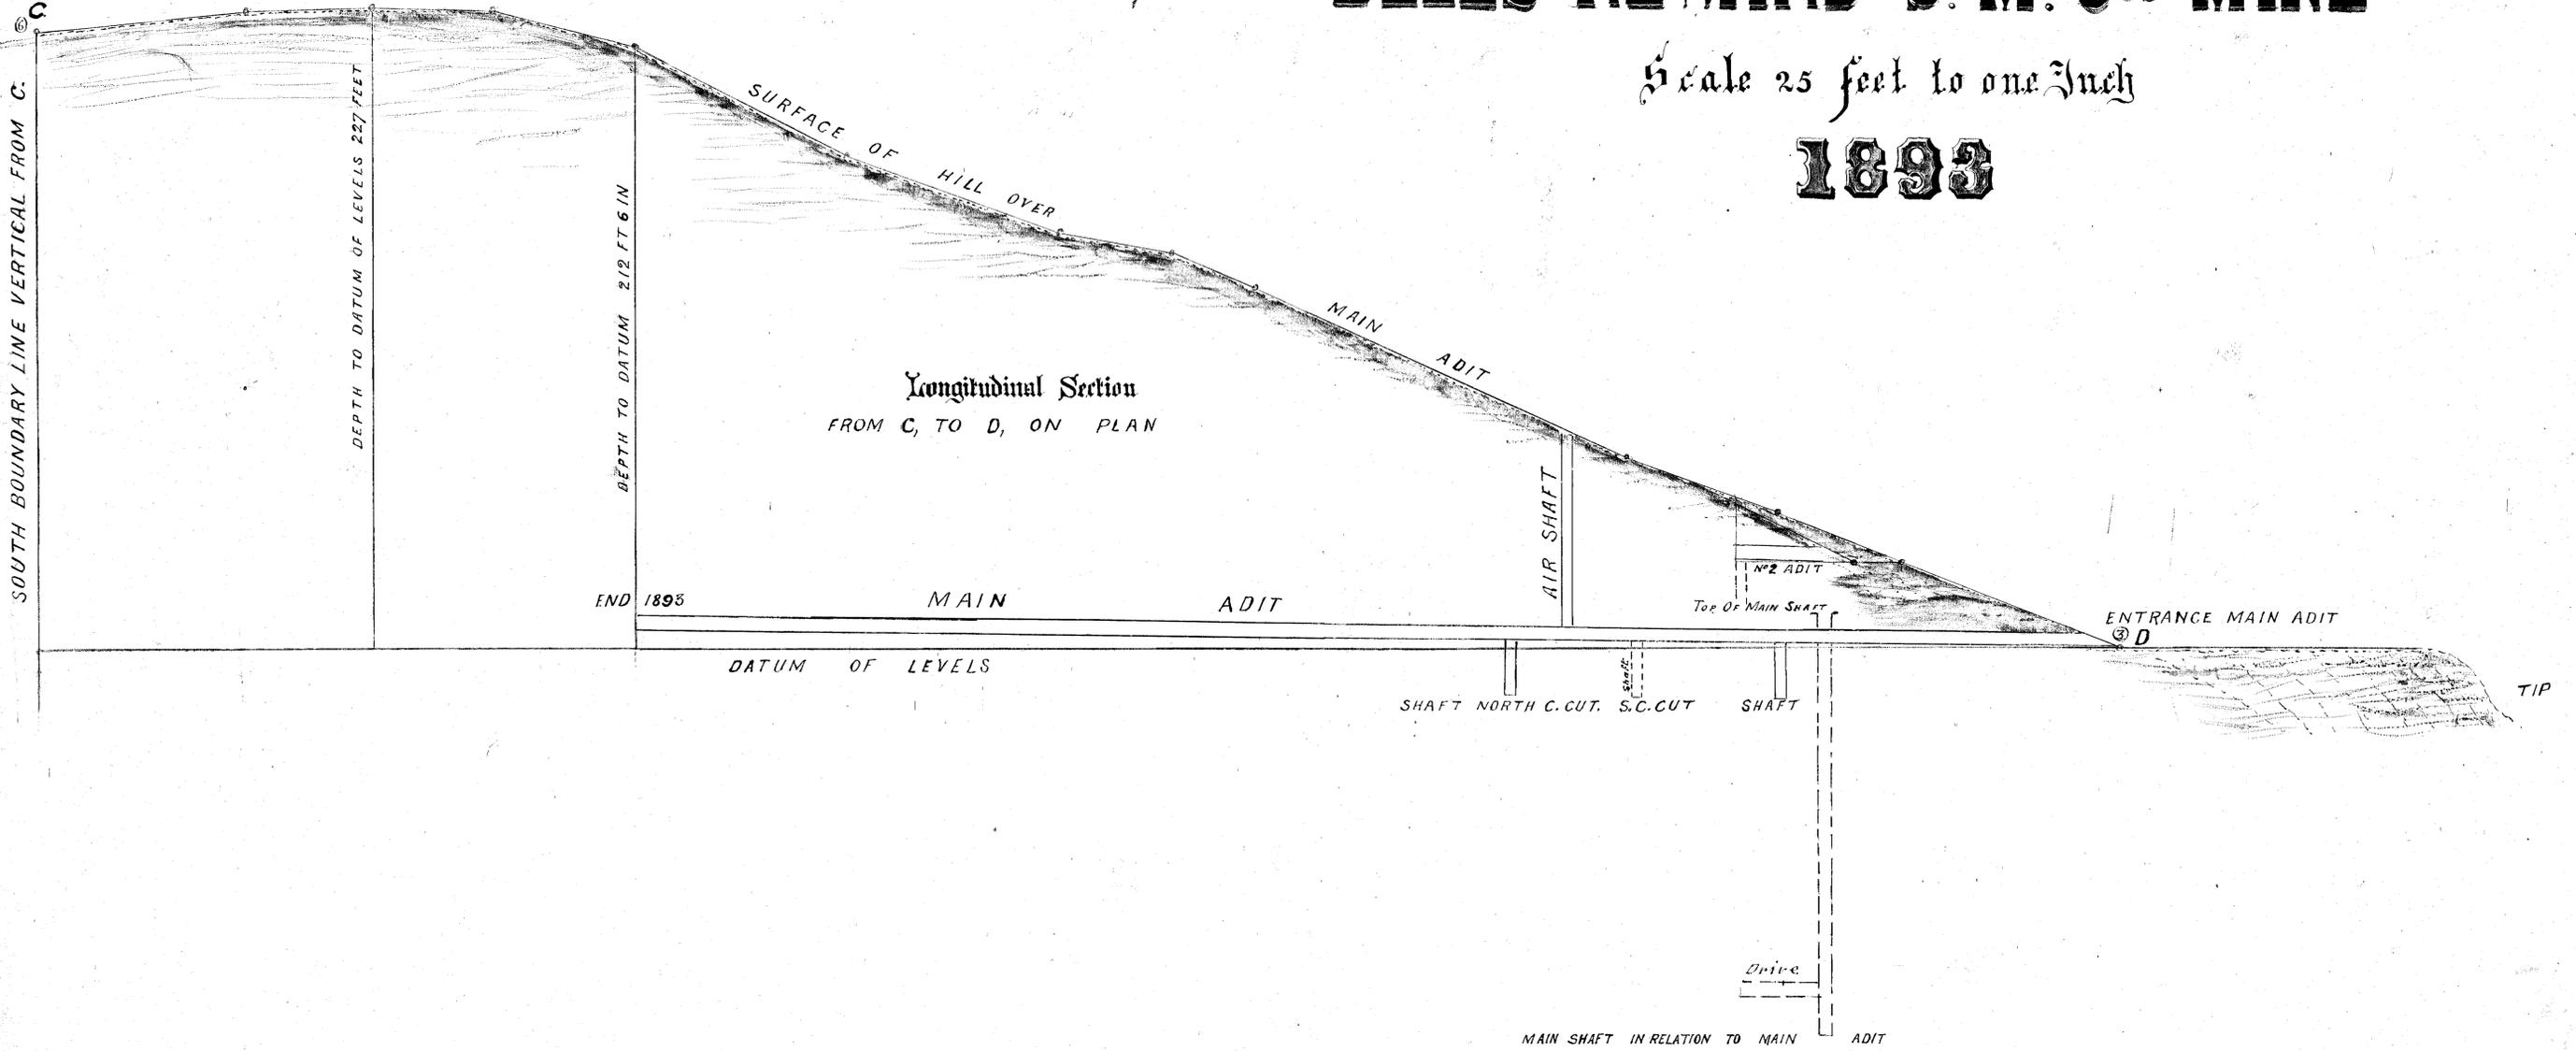

Surveyed in accordance with Regulations  
of Mines Act 1881 and 1884 .  
Waratah Feb<sup>y</sup> 20<sup>th</sup> 1893

*Lewis Jones,*  
District Surveyor