


173-03

173-03

5 cm

# WEST CHUM C.M. CROSS SEC<sup>TM</sup>

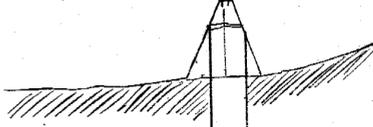

SHAFT

Nº7 LEVEL

*Verified correct  
copy of plan of workings of  
above mine for 1890  
C. Bailey Watson*