
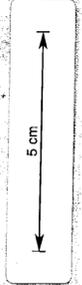


WEST CHUM C.M.

GROUND PLAN

Scale 25ft to an inch

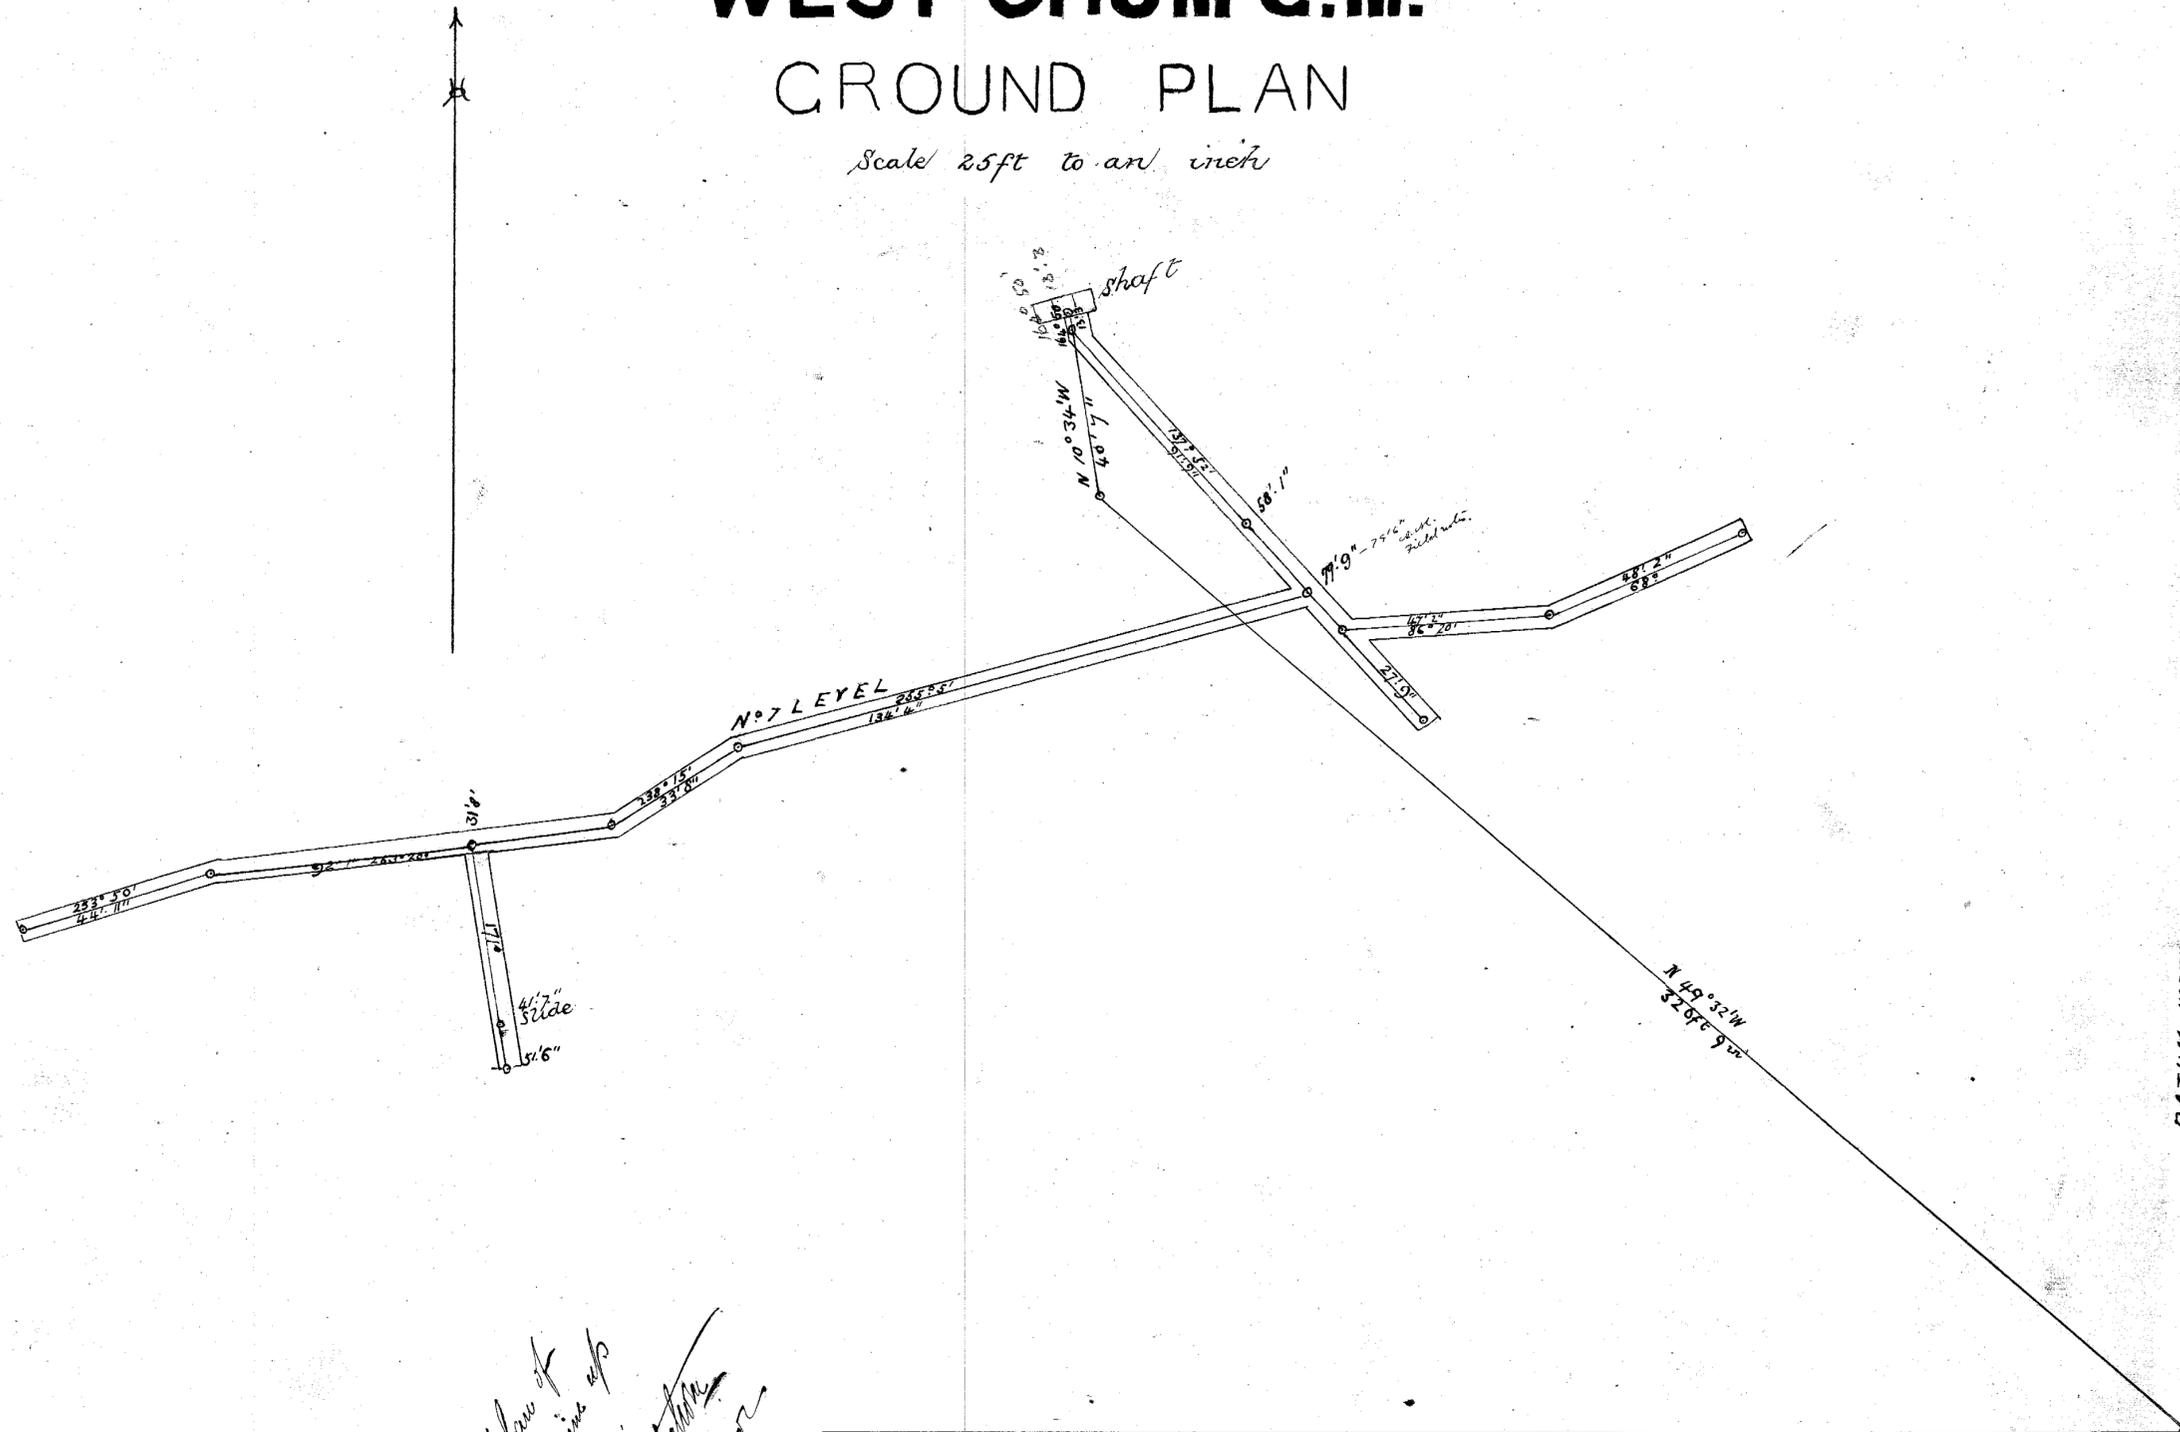

Σ
d. m.
4/4/21

173-06

*Original correct plan of
workings of above mine up to
and of year 1891.
C. Bailey West Chum
A. H. ...*