

NEW CHUM G.M.C^o

PLAN


OF
UNDERGROUND WORKINGS.

Scale 25 feet to an inch.

GROUND PLAN.

CROSS SECTION

LONGITUDINAL SECTION

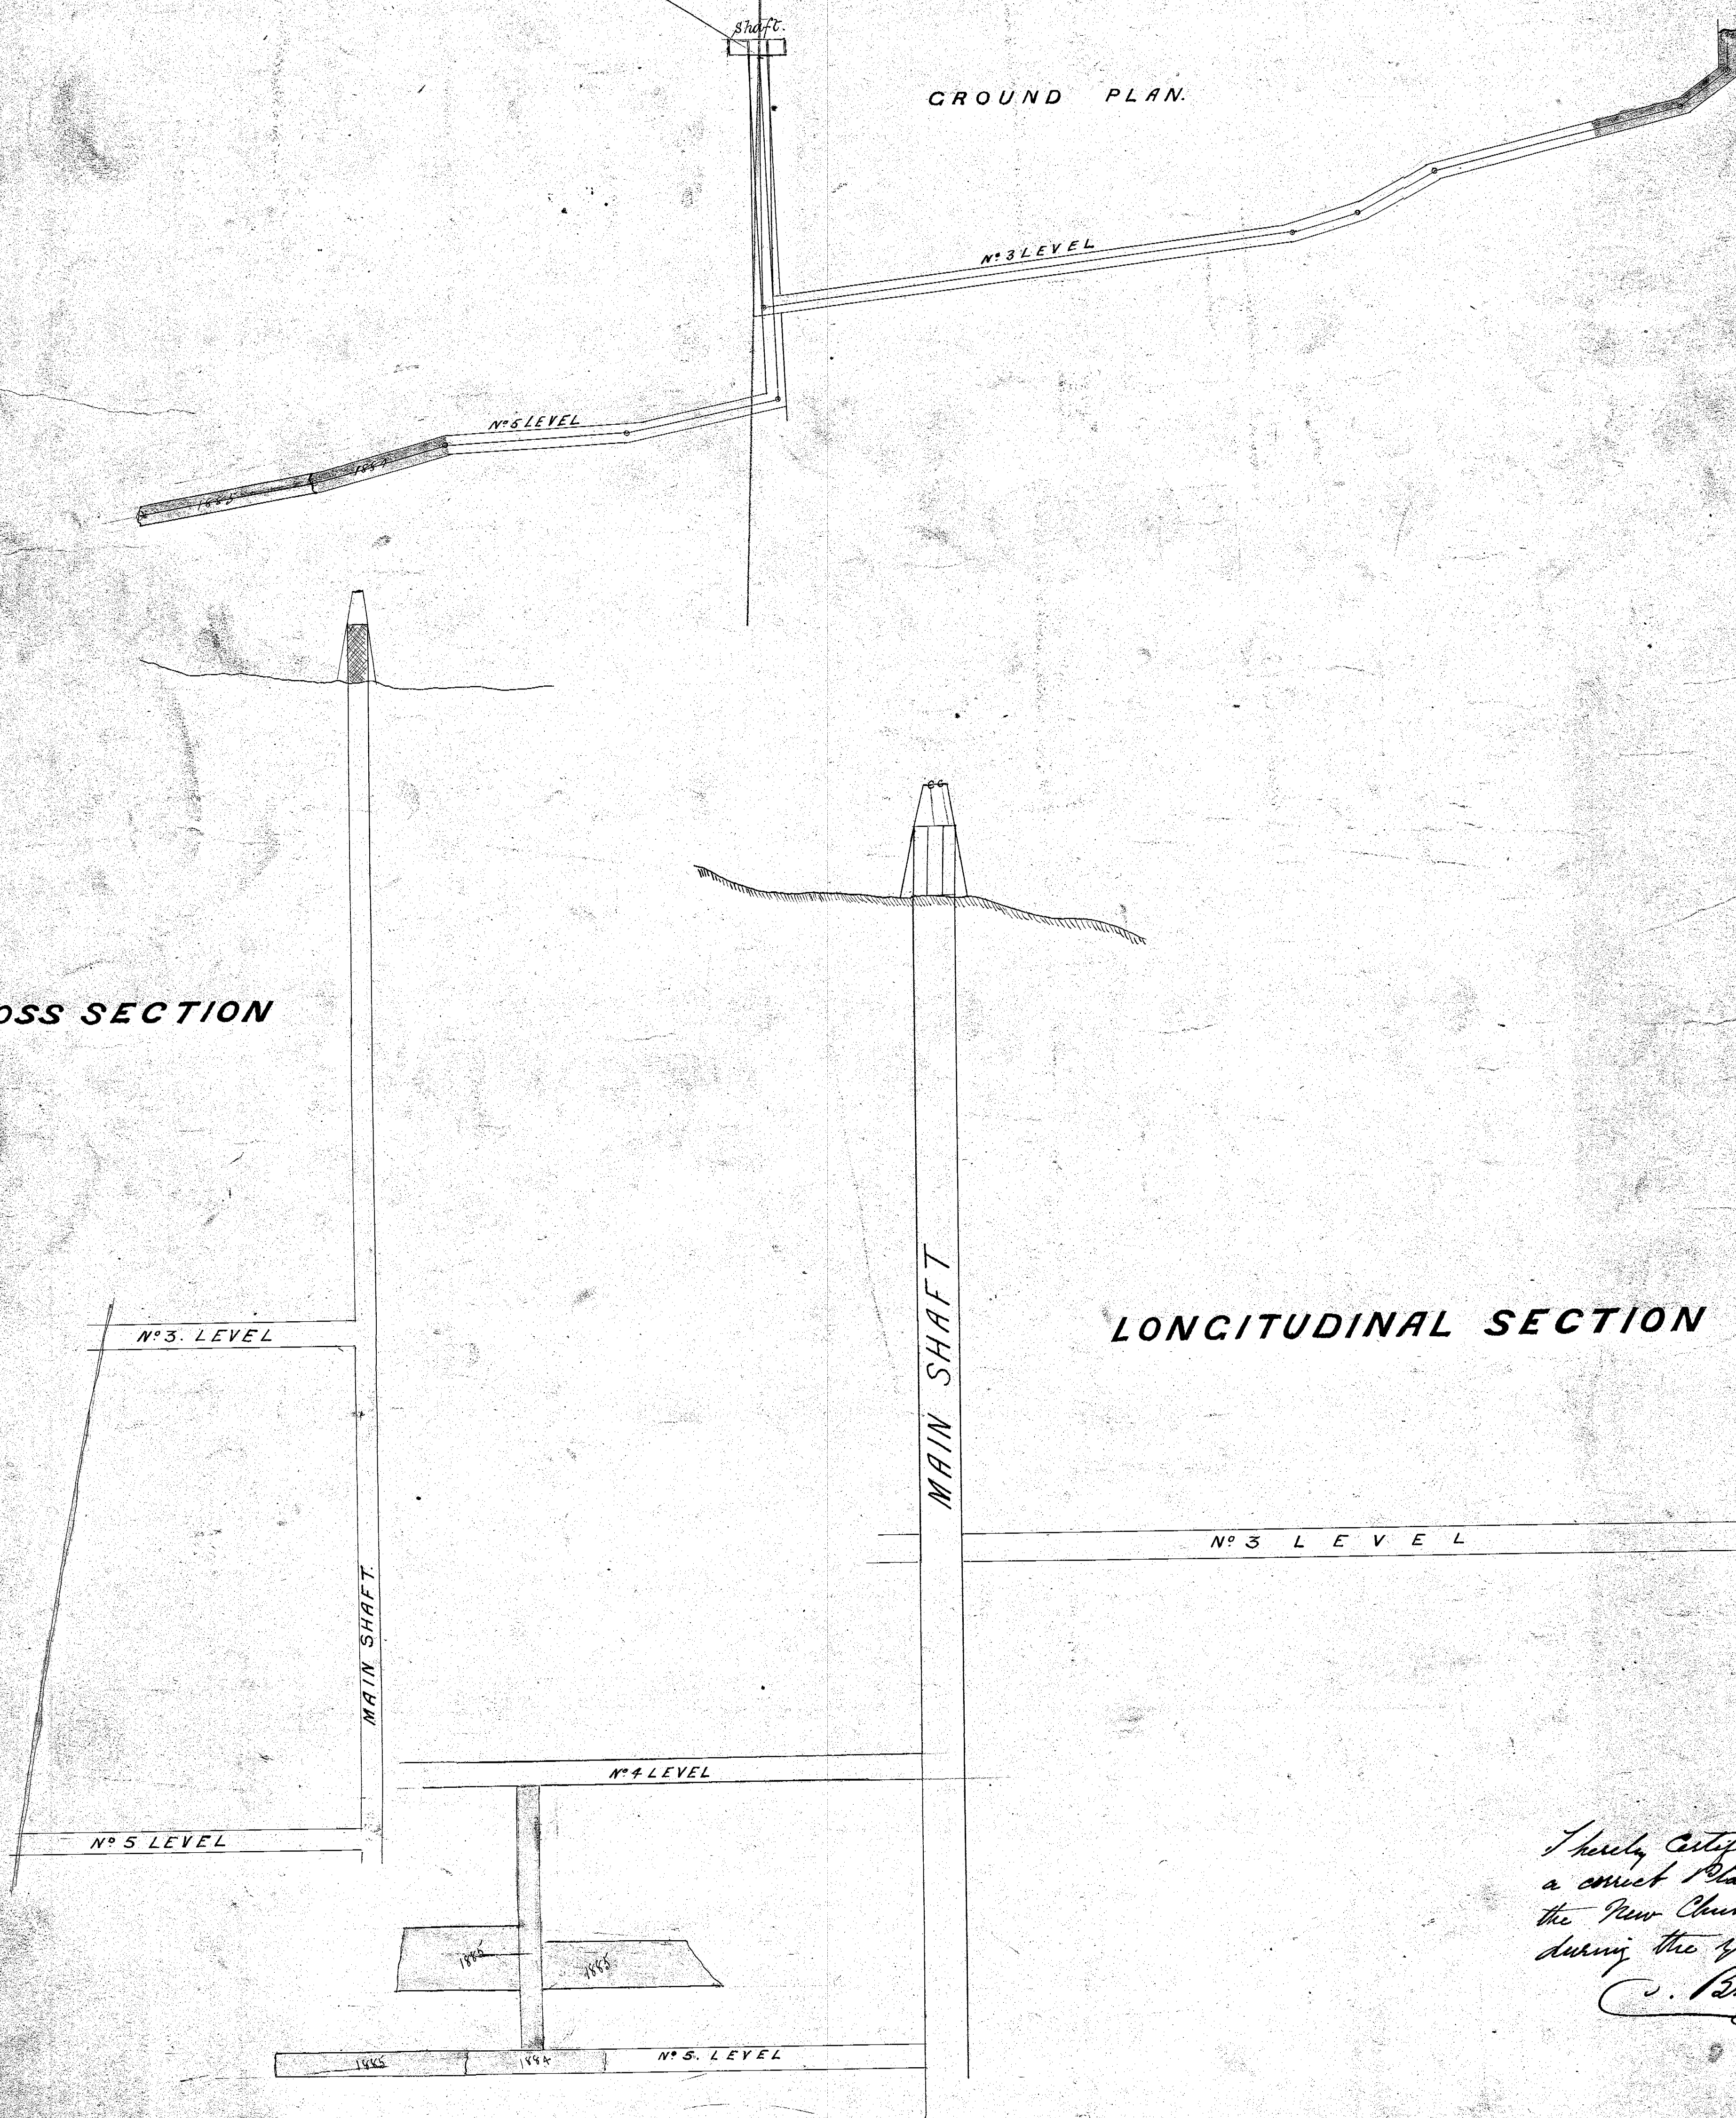

I hereby certify that I believe this to be
a correct Plan of the work done in
the New Chum Gold Mining Co.
during the year 1884 & 1885

C. Briggly Watchdog
Authorized Surveyor