


References

Shaft	
Crosscuts	
Reef	
The Collier Red is branch reef.	
Off from Main reef. The same interval	
Main reef at 400 feet	

Cross Section
— of the —
New Chum Gold. M.C.
Scale
4 Inches to 100 feet
25 50 75 100

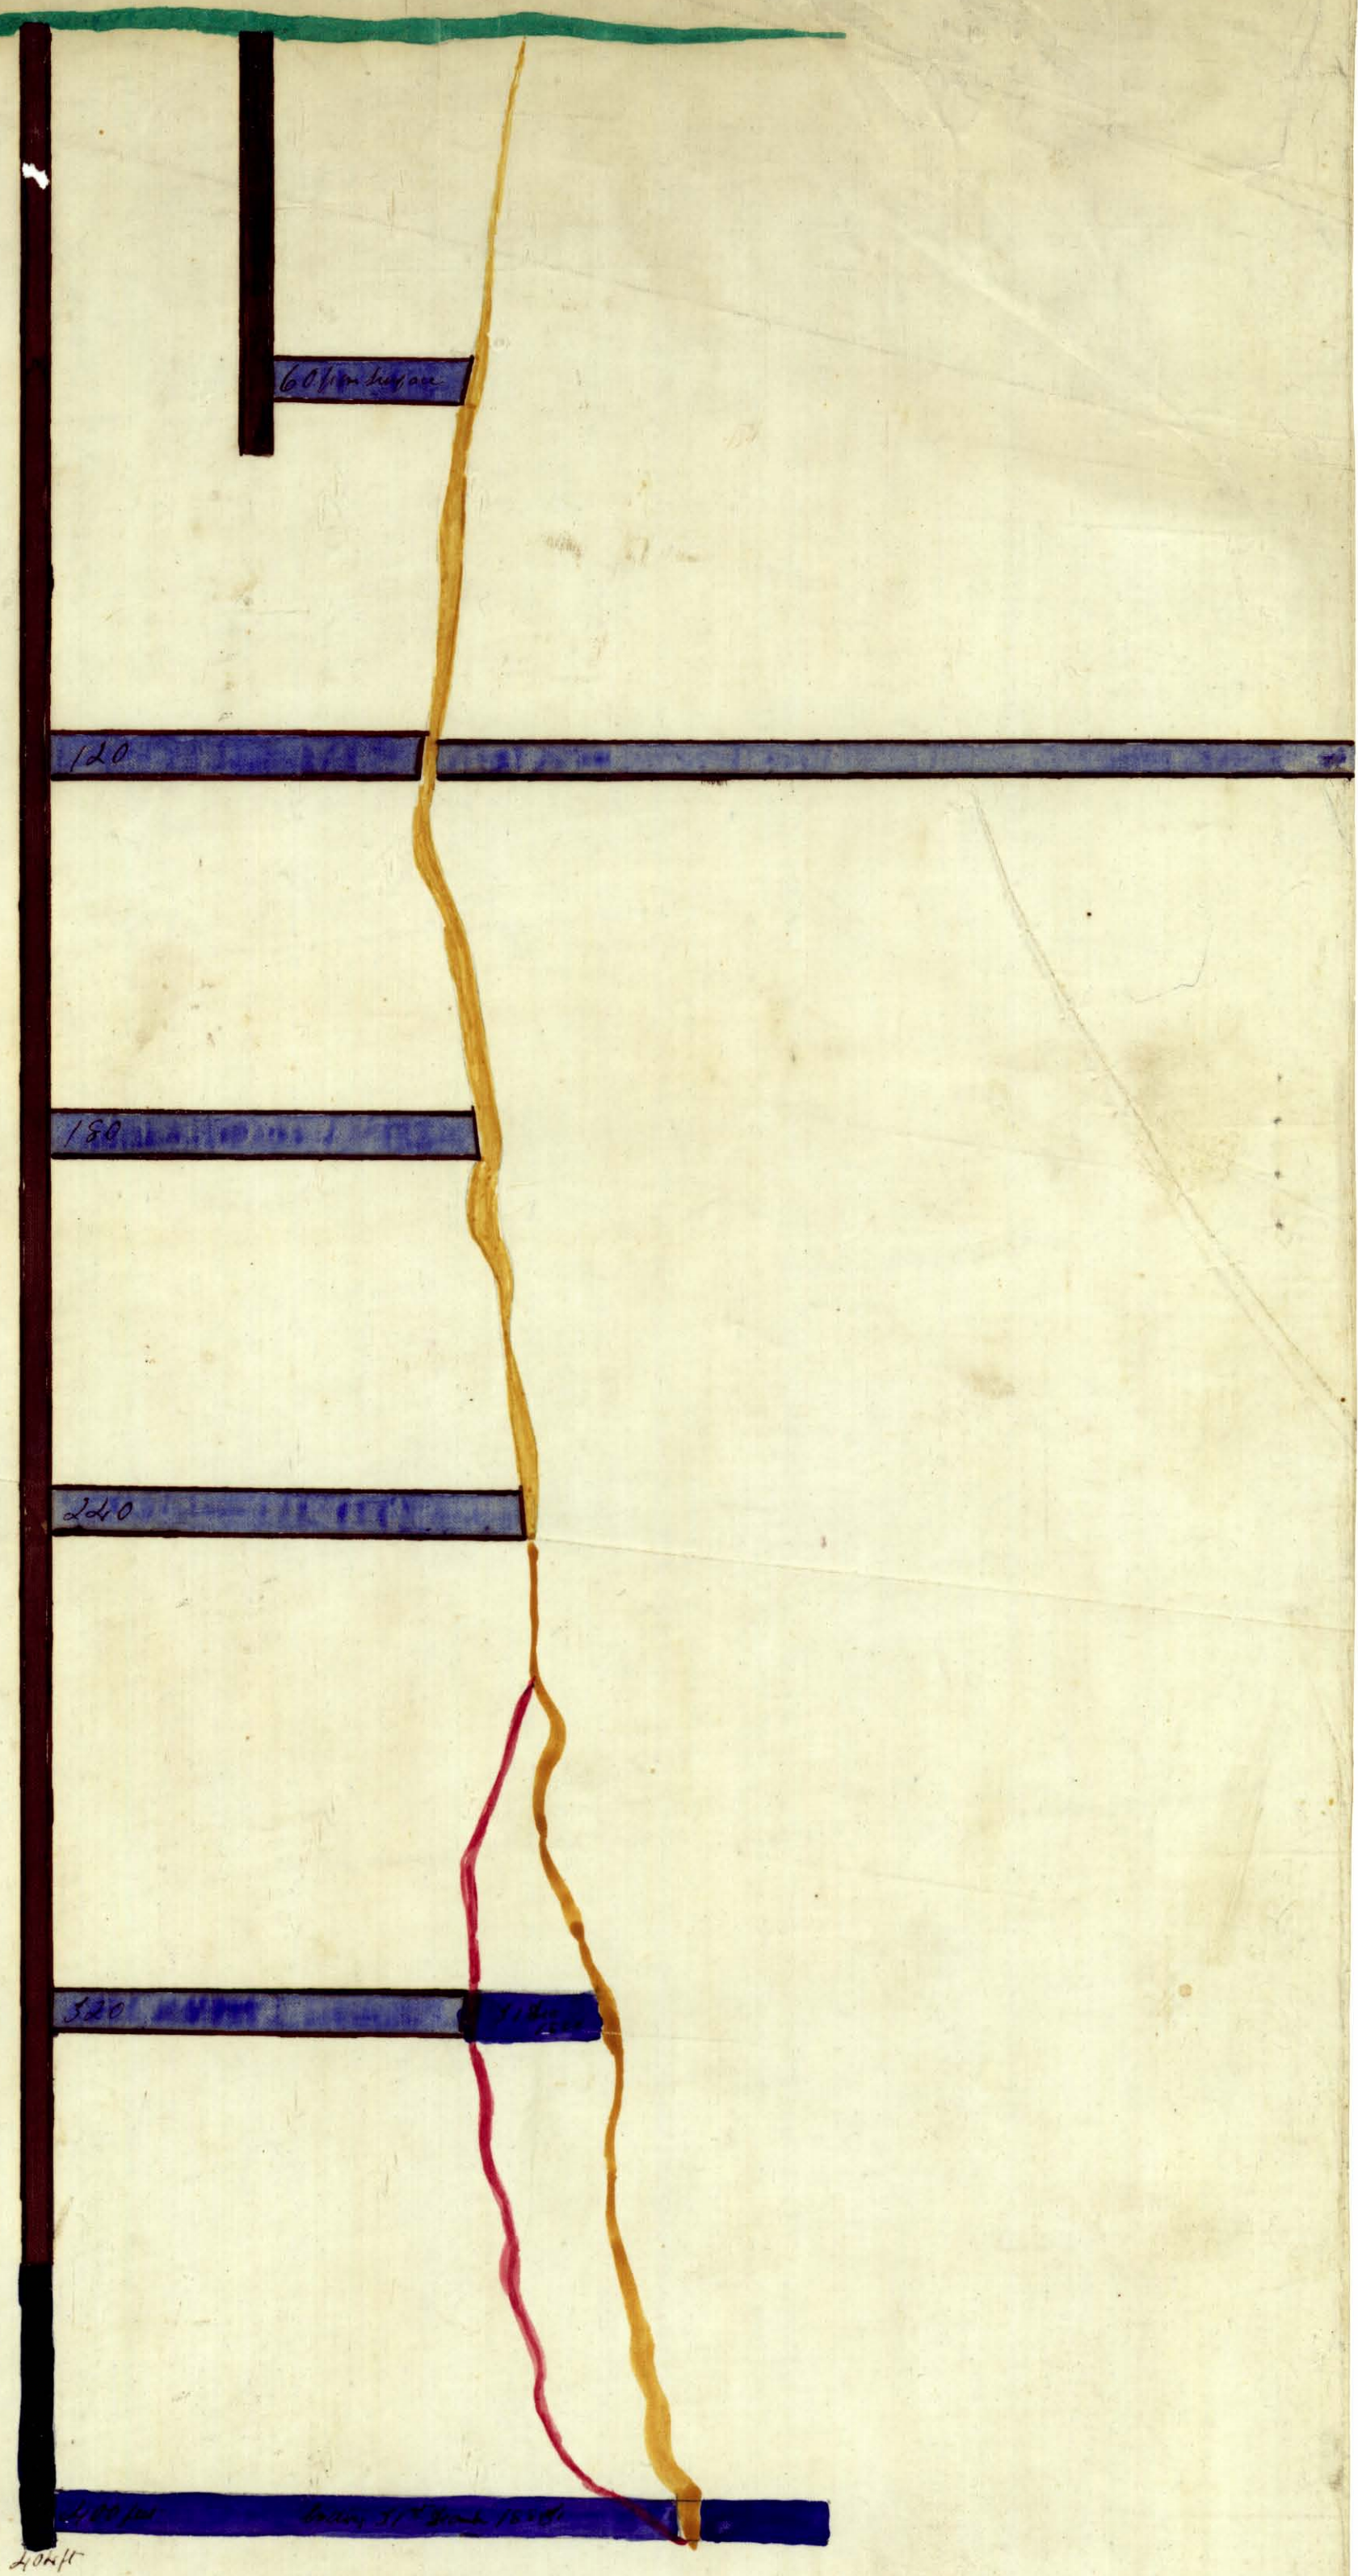

By
A. D. White
Mining Manager
Additions by H. Badger
Mining Manager