

Longitudinal Plan
of the
New Chum Gold M^o.

By
A. D. White
Mining Manager

Additions by H. Parker Mining Manager


East Chum S. M. Co. Boundary

West Chum S. M. Co. Boundary



scale
4 Inches to 100 feet

25 50 75 100

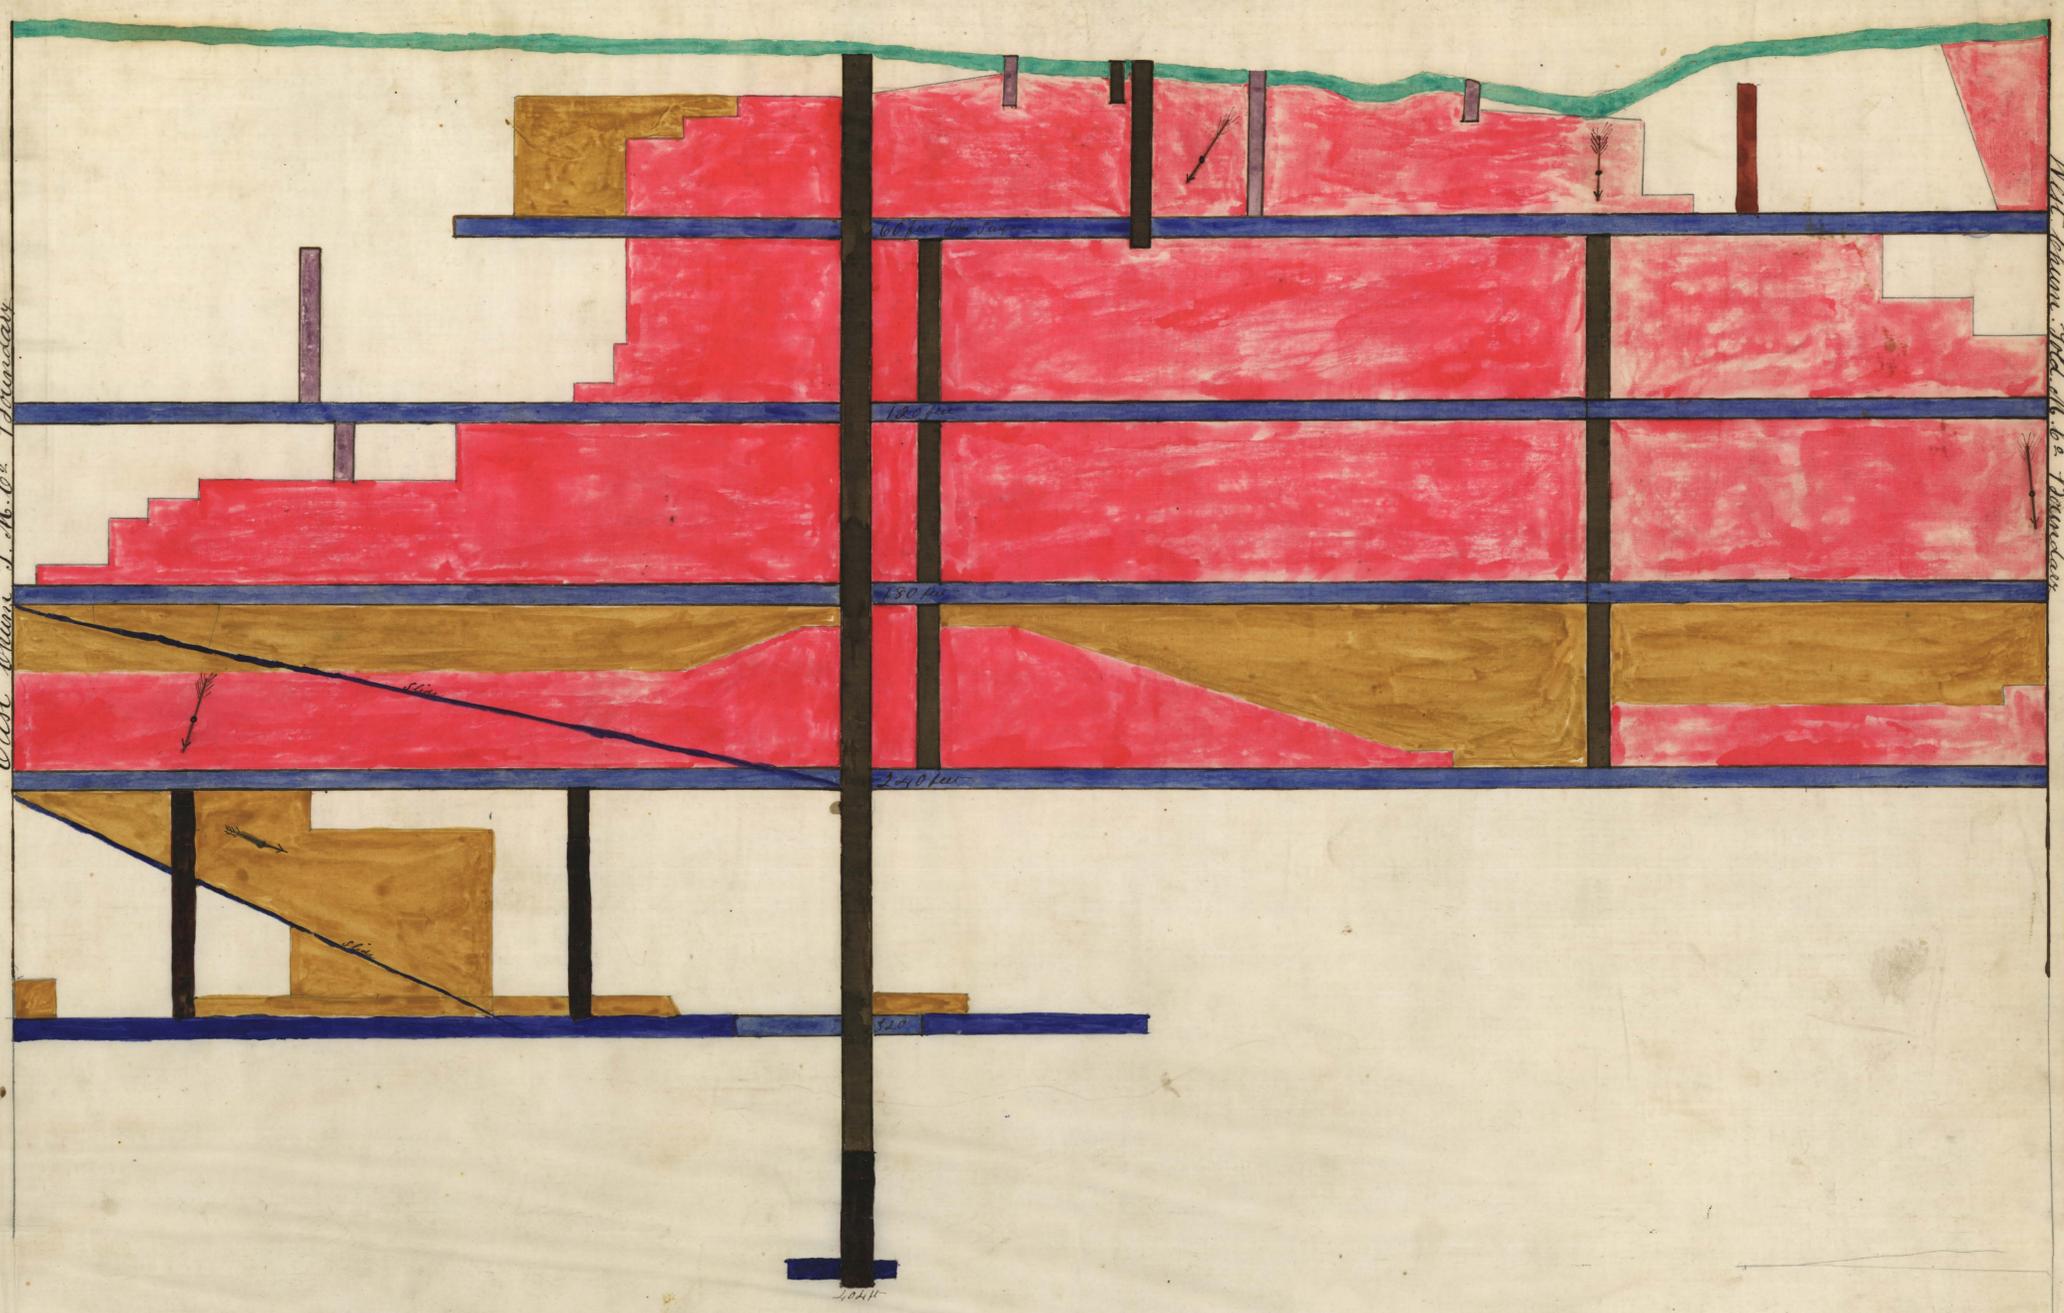

scale
2 1/2 in to 100 ft

References

Shafts and Drifts	Black line
Ground not Worked	Yellow
Drifts	Red
Ground Worked out	Red
Pisces	Purple
Surface	Green

The additional claims is the amount
of ground worked ending December 31st
1885

Drifts	Red
Ground worked out	Red
Shafts and Drifts	Black line
Pisces	Purple

174-03



174-03