
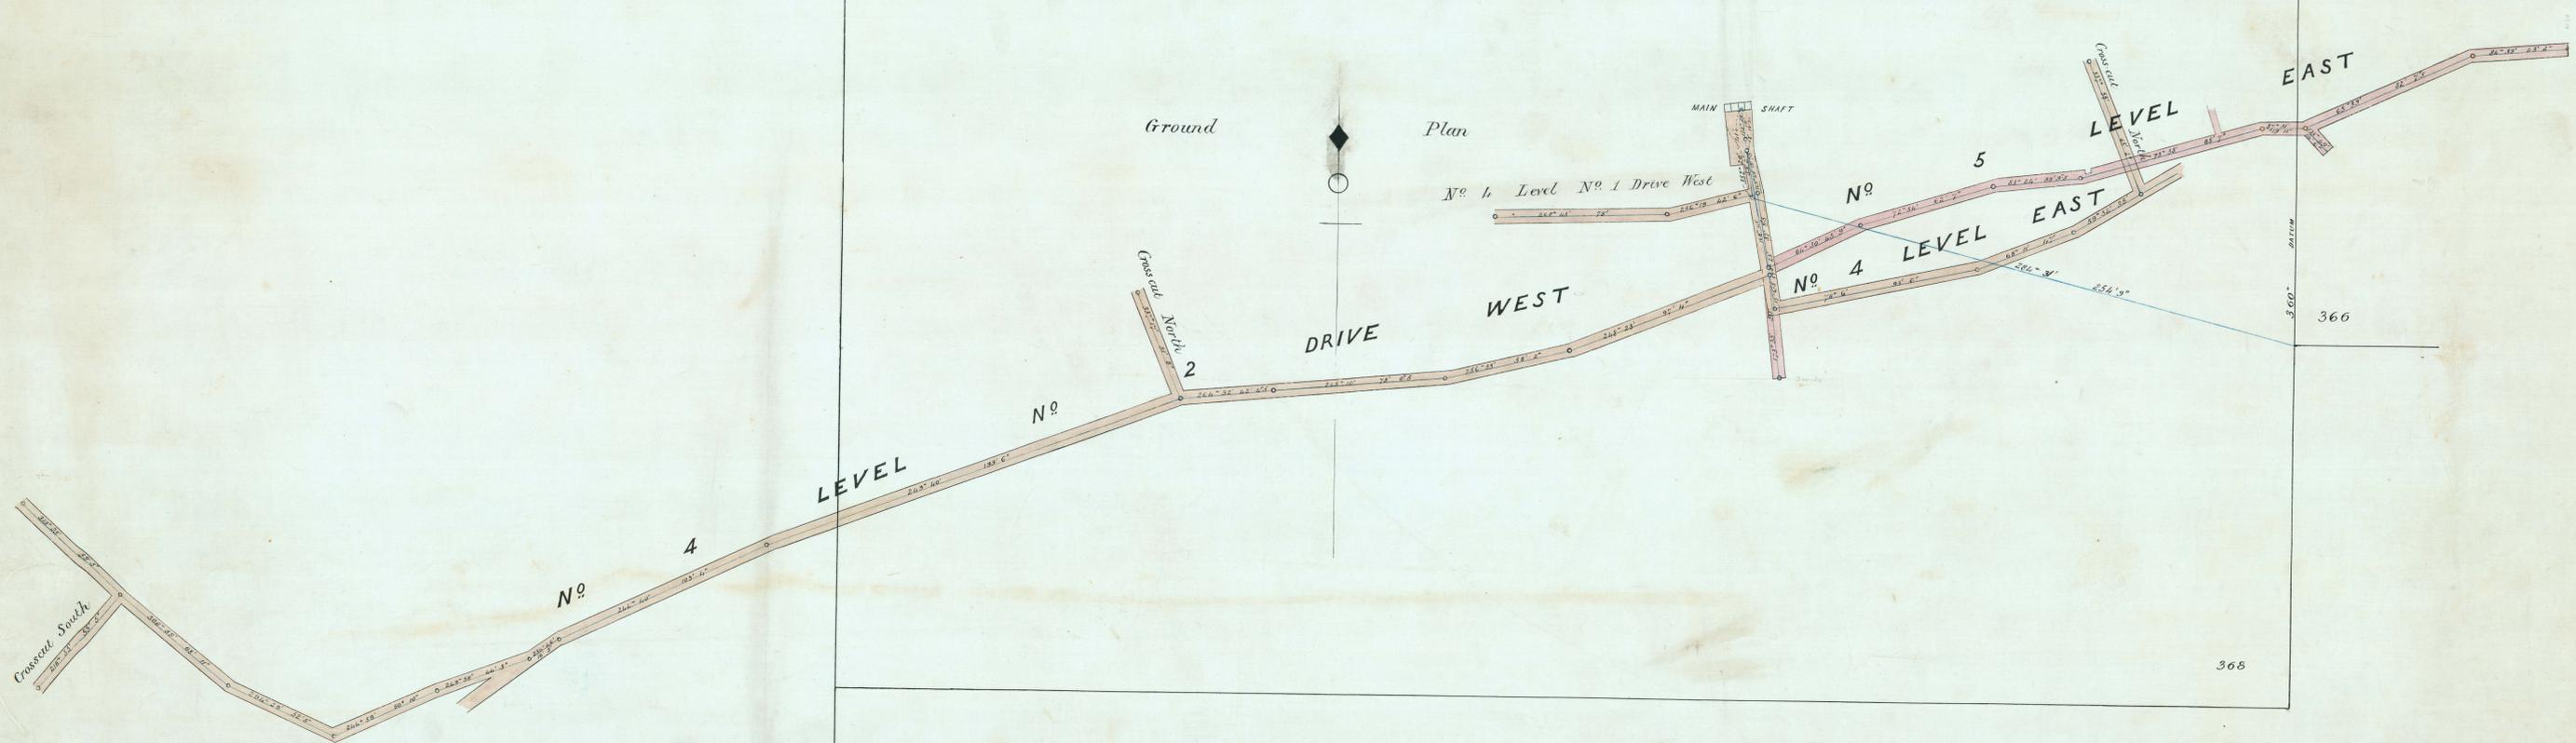


Longitudinal Section

References

- No. 5 Level
- No. 4 Level
- Ground Stopped

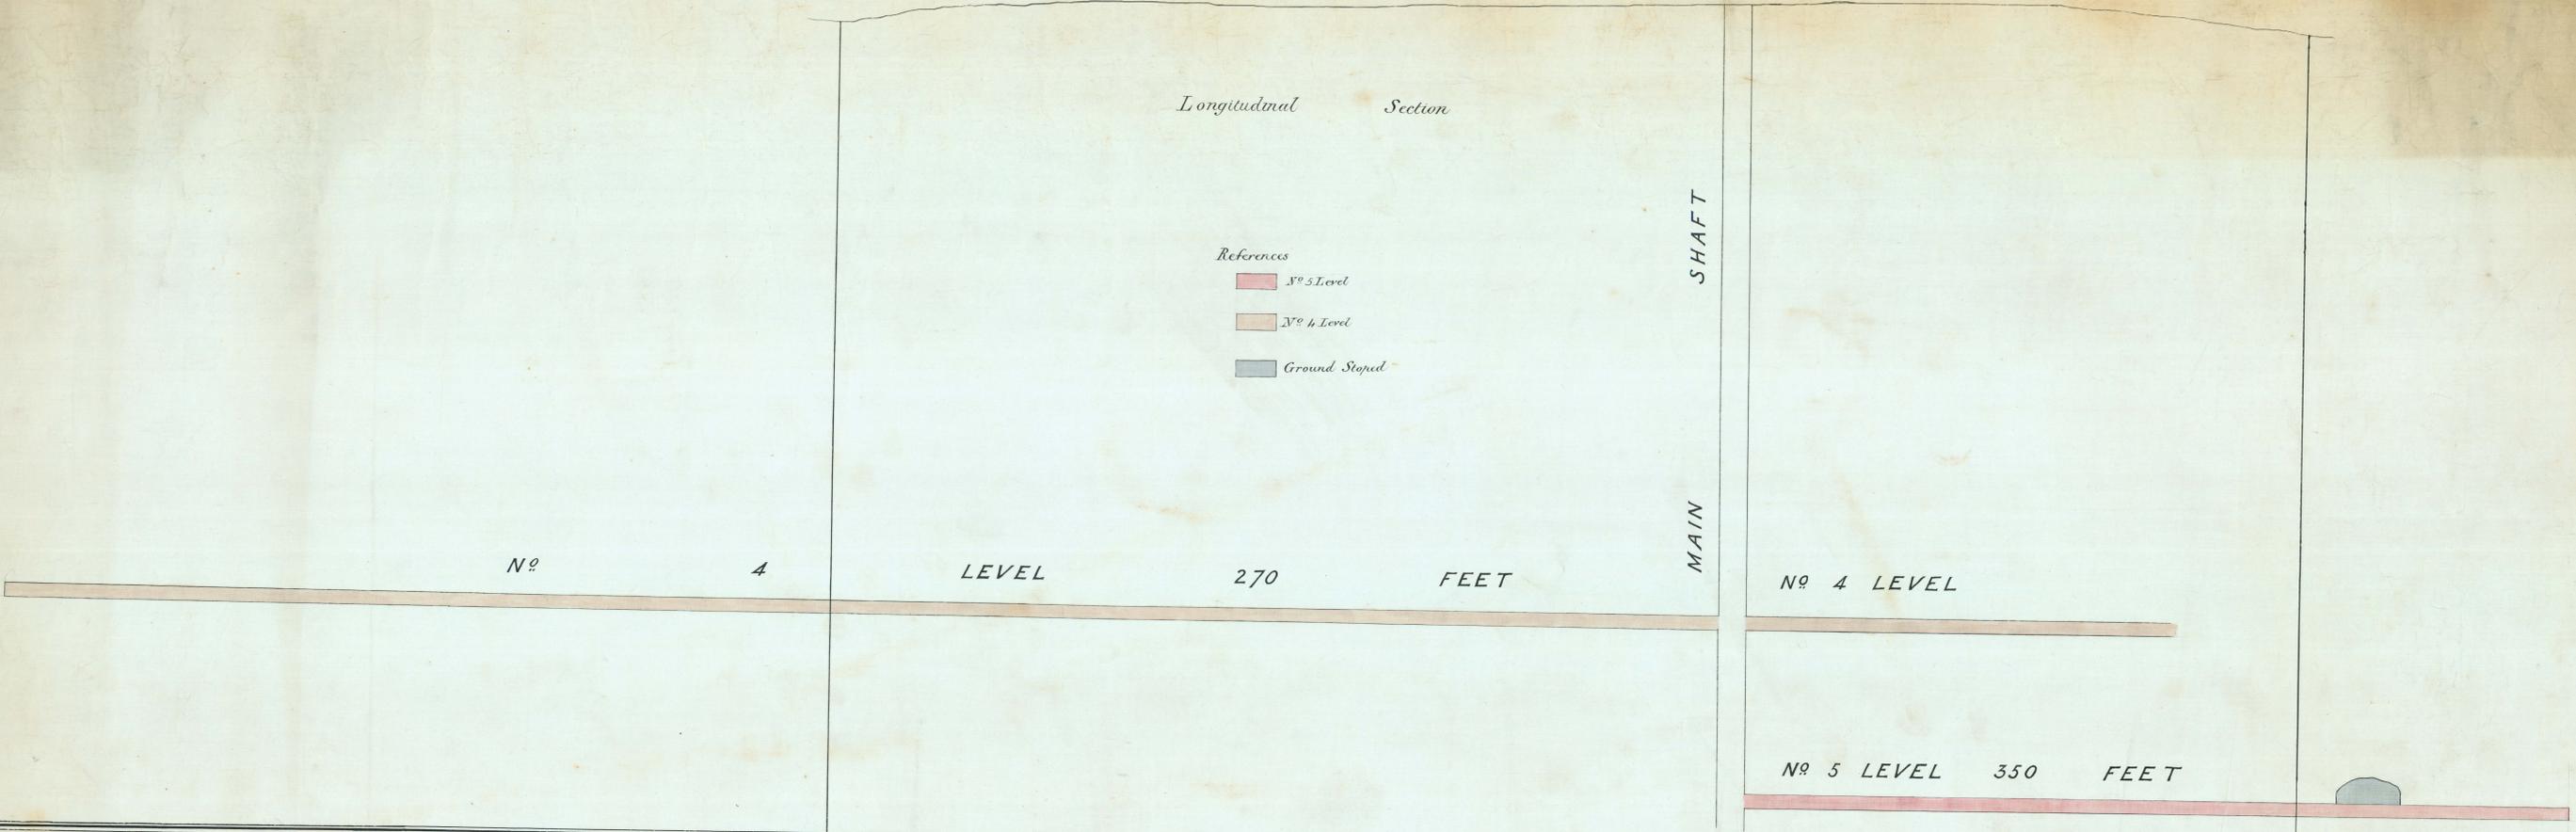

Correct copy of plan from actual survey with
5" Transit theodolite

H. F. Hills
Authorized Surveyor
Sept 18/1/95.

1895
JAN. 18/1/95