



Chums Proprietary G.M.C<sup>o</sup>.NO.LIA

# LEFROY

Scale 25 feet to an inch

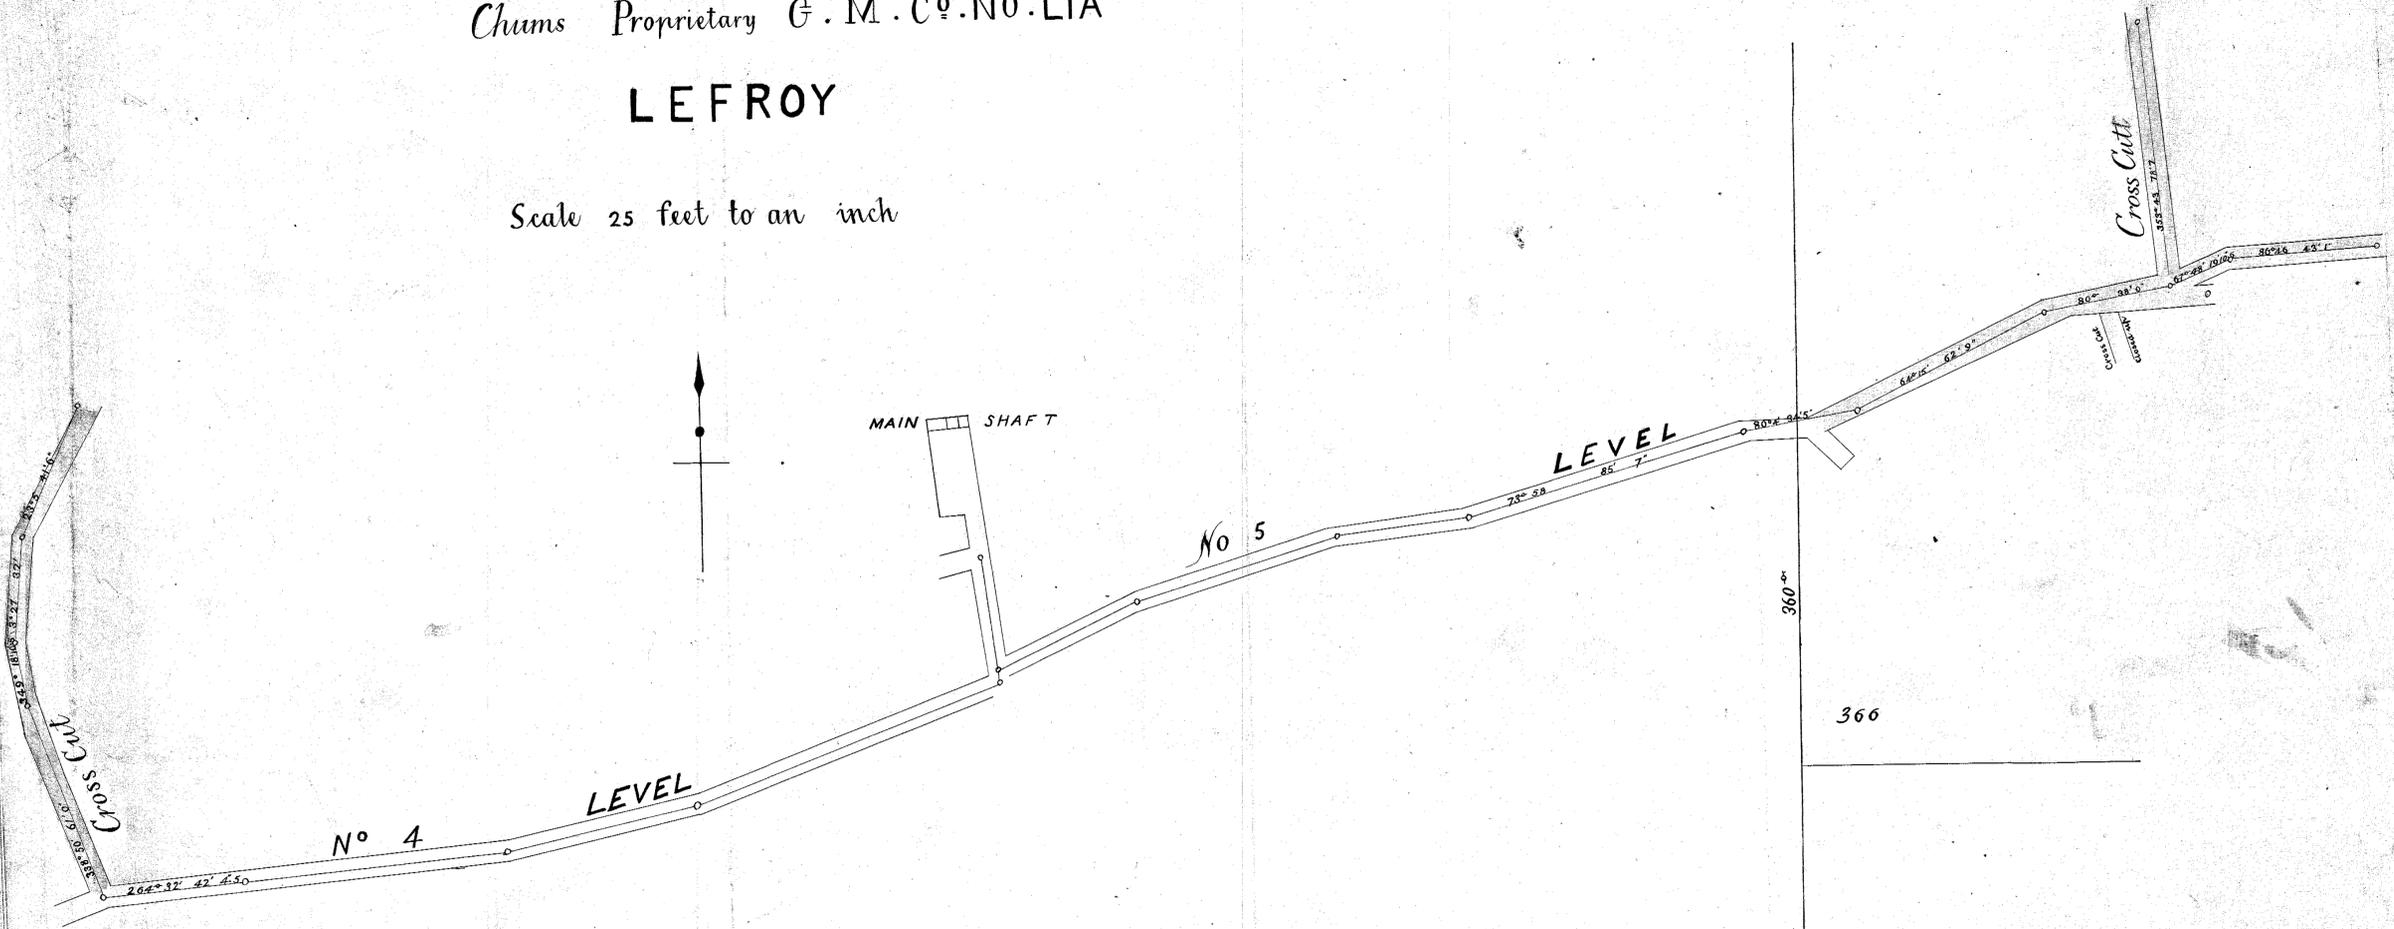

175-01  
TOP L PAGE

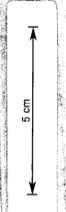

175-02



H. J. Mills  
Authorized Surveyor  
Lefroy.  
January 1896.