



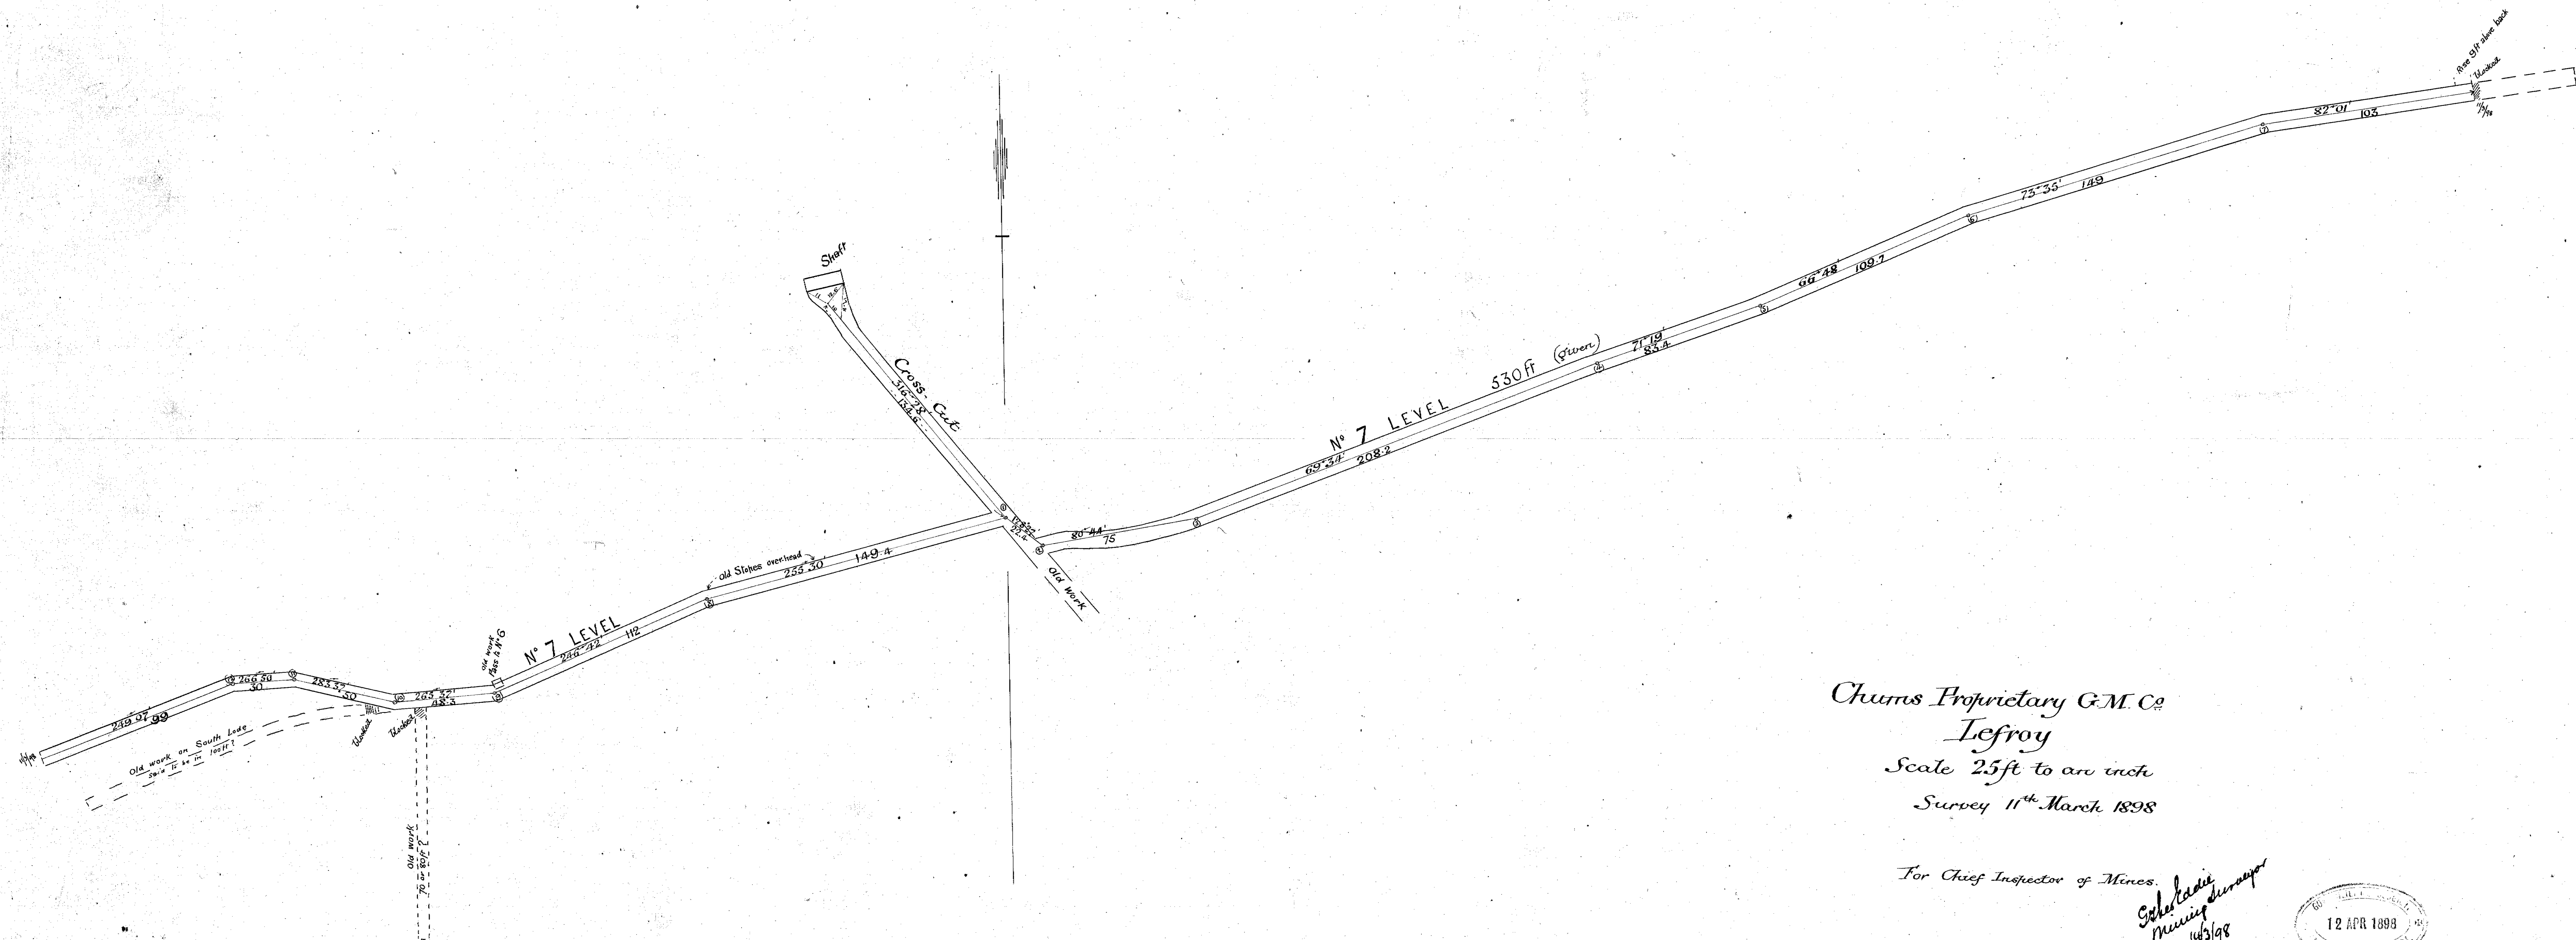

Chums Proprietary G.M. Co.
 Tefroy
 Scale 25 ft to an inch
 Survey 11th March 1898

For Chief Inspector of Mines.

G. H. L. L. L.
 Mining Engineer
 14/3/98

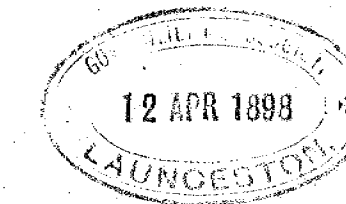

175-03

175-03