



175-04

175-04

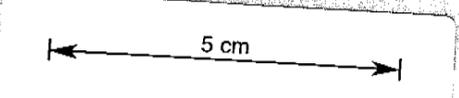


Chums Proprietary G.M.C^o. No Liability


Scale 25 ft to an inch

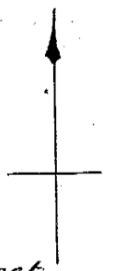

N^o 6 Level 430 feet

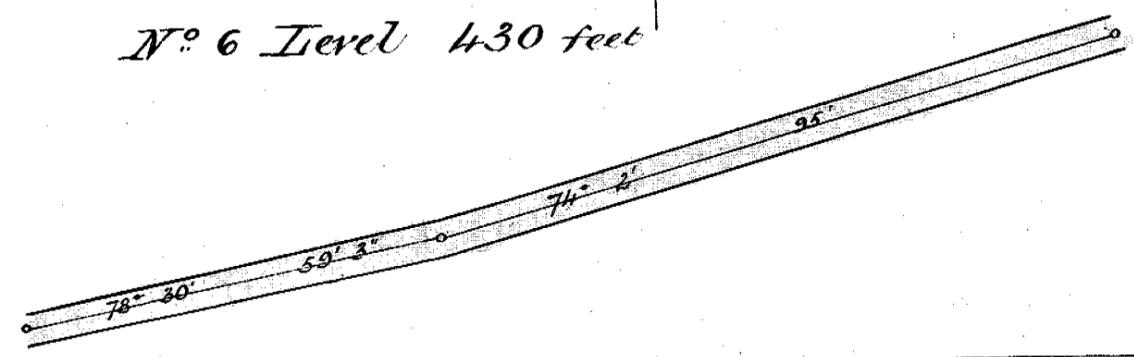

N^o 7 Level 530 feet

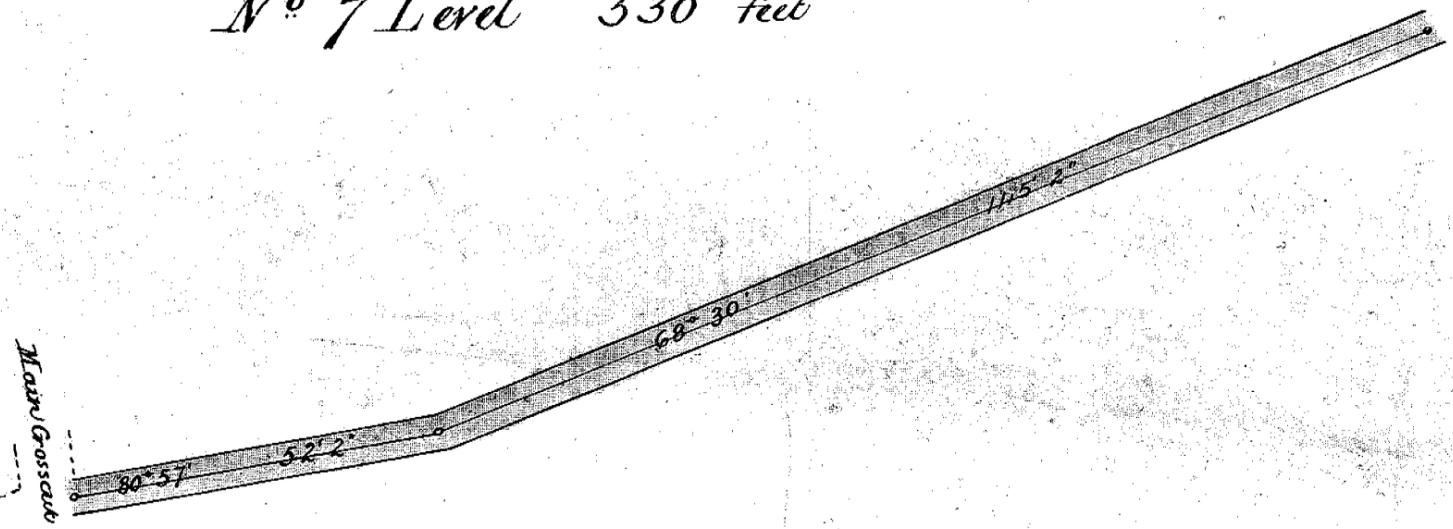

INSPECTOR OF MINES
5/2/97
LABORATORY

INSPECTOR OF MINES
LABORATORY

H. J. Miles
Authorized Surveyor
January 97