


5 cm  
176-01  
1239 93  
176-01

# SALMON COLD ESTATES WEST MIAMI MINE

SCALE 25 FEET TO AN INCH

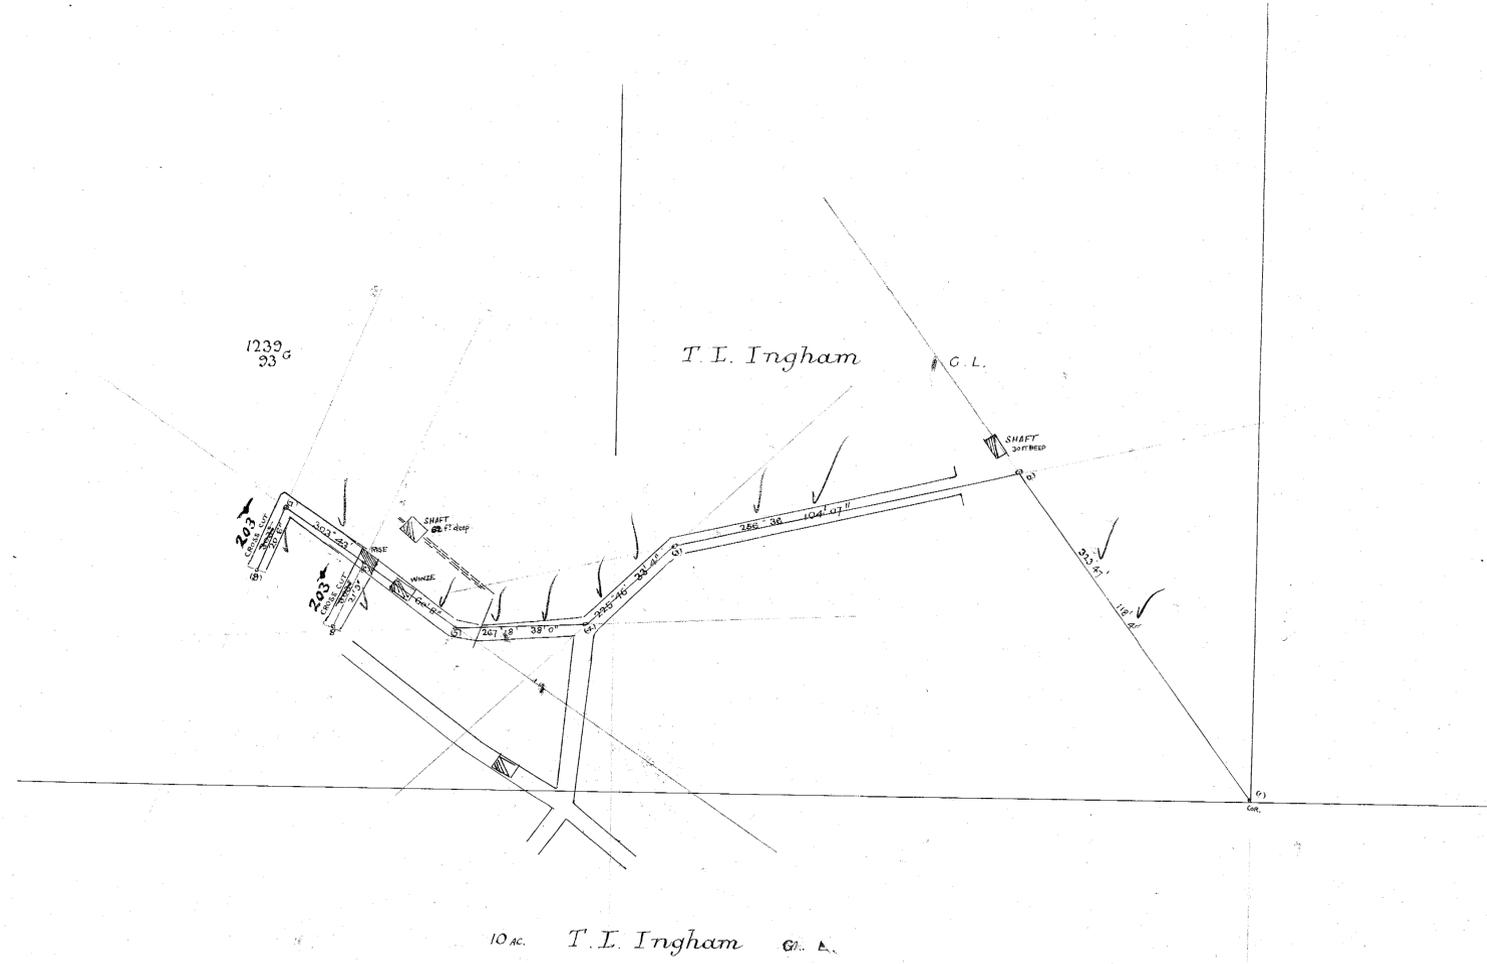

Survey Begun & Finished 11.1.02

Campbell Smith  
authorized surveyor

Surveyed with transit theodolite

