


176-03

SALMON COLD ESTATES

WEST MIAMI MINE

SCALE 25 FEET TO AN INCH

1239
93 G 10 AC.
T. L. Ingham G. L.

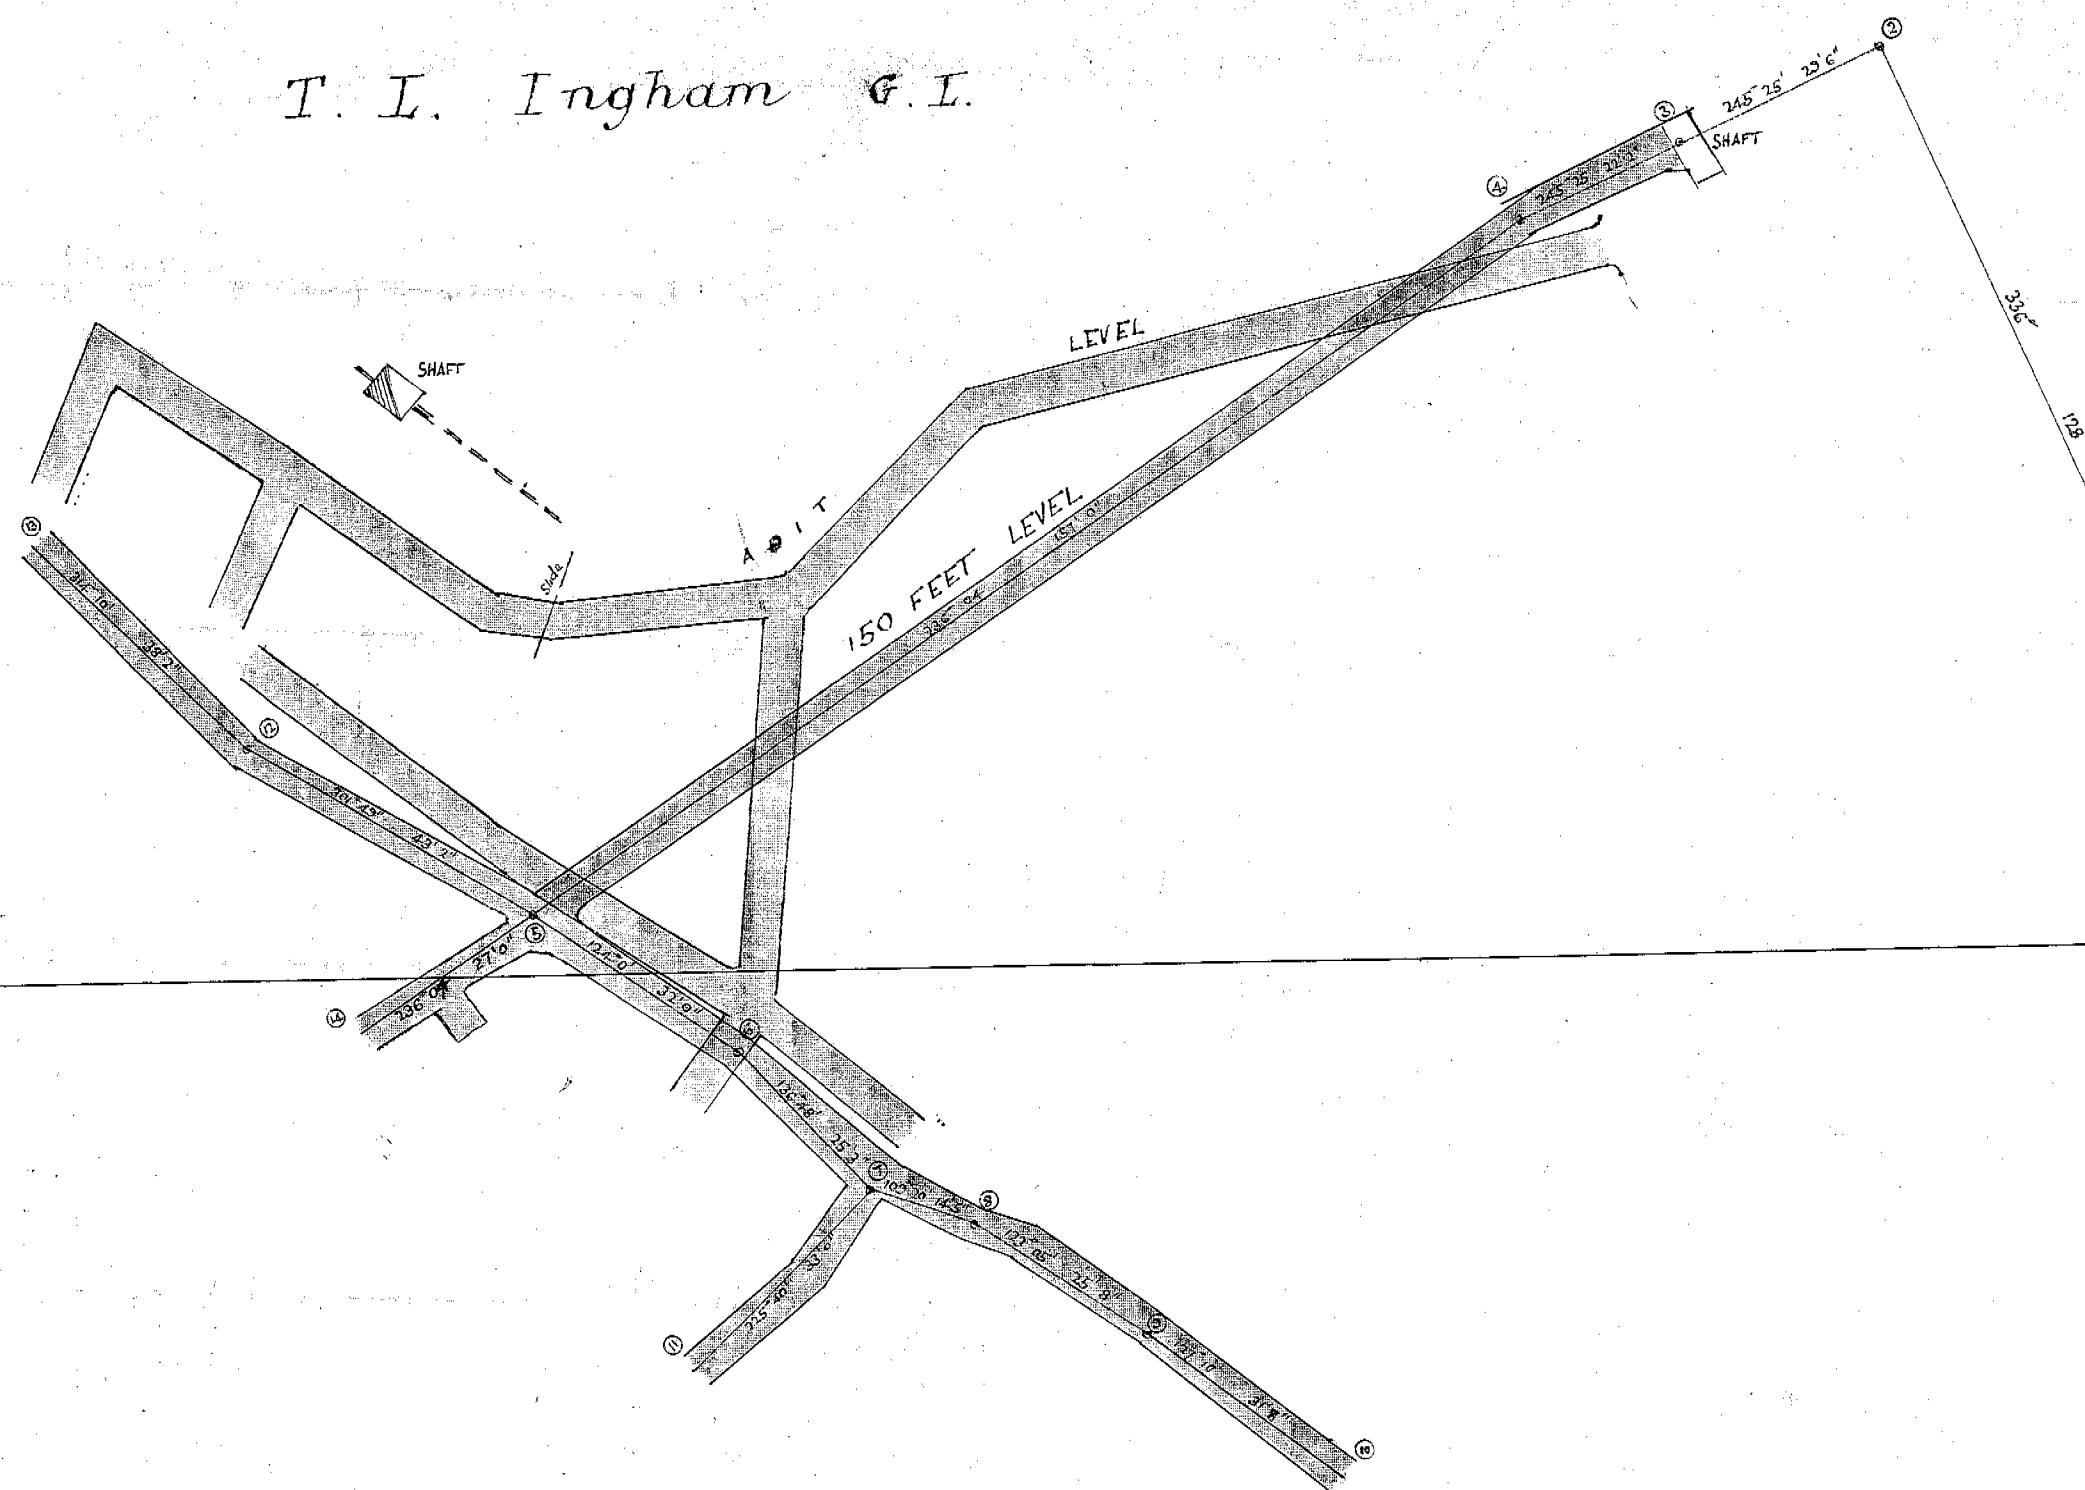

10 AC.
T. L. Ingham G. L.

Le Campbell Smith
Authorized Surveyor

Surveyed with 4' transit theodolite.
April 1903

