


177-01

177-01

Longitudinal Section Chums Co

5 cm

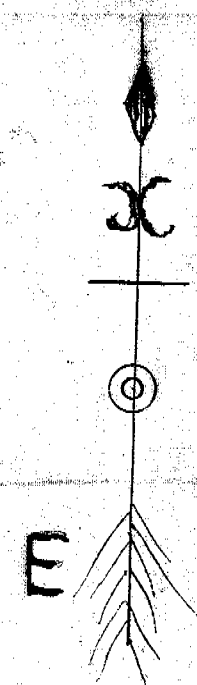

10/4/94

Geo. J. Kite



W

work done for 1893 marked.

Nº 1 LEVEL

MAIN SHAFT

Nº 1 LEVEL