

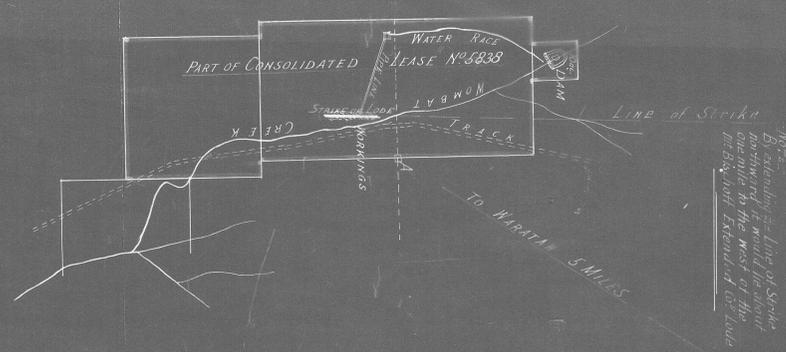


176-02

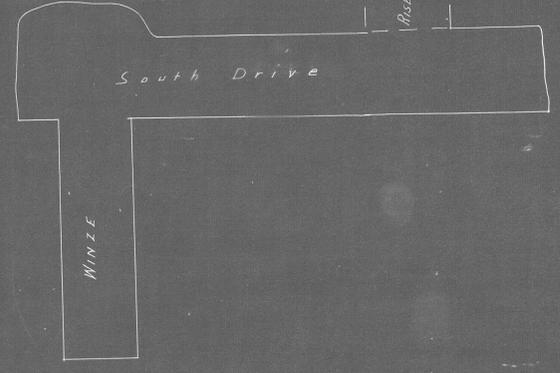

WOMBAT TIN MINE

Showing Position of Assay Samples
 down to 30 f.
 Markings and Assay Values copied from original Plan
 Scale 5 f. to an Inch

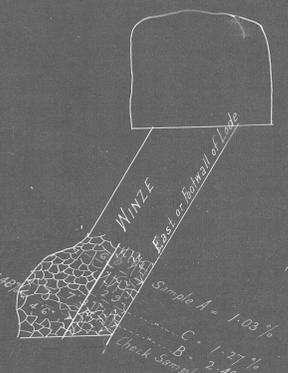

Samples taken from South Face of Winze
 1.9% Tin Dioxide
 2.25% metallic Tin

176-02



WOMBAT TIN MINE

Mt. Bischoff - Tasmania
 Scale 40 f. to an Inch
 Underground Work in Pink


W.A. Cundy
 Oct. 1916

CONSOLIDATED LEASE
 N° 5838 161 AC.

PLAN



CROSS SECTION AT A B

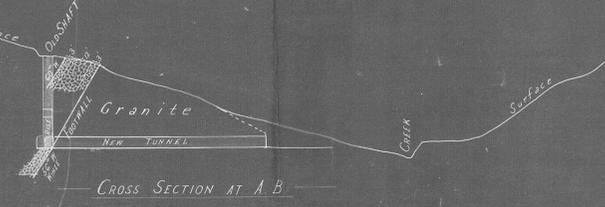

LONGITUDINAL SECTION C. D.

Corner Peg A on Locality D. 11