

3575-M.

3576-M.

3577-M.

3714-M.


179-03

50m

3578-M.
3578-M.

179-03

PLAN
OF THE
CHESTER MINE.
LEASE 2030-M, NORTH PIEMAN, TAS.
SCALE: 50 FEET TO ONE INCH

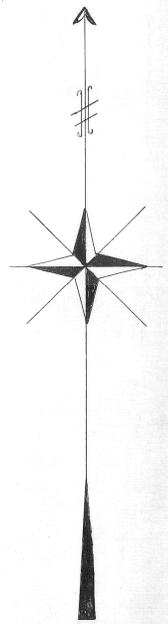

*Instrument used: a 5" Y theodolite,
transit reading to 1 minute.
Marks: James White, Glasgow
J. H. Conroy,
Surveyor,
Chester Mine,
Chester.*

Feb. 23rd 1912

3435-M.

3714-M.

