


179-04

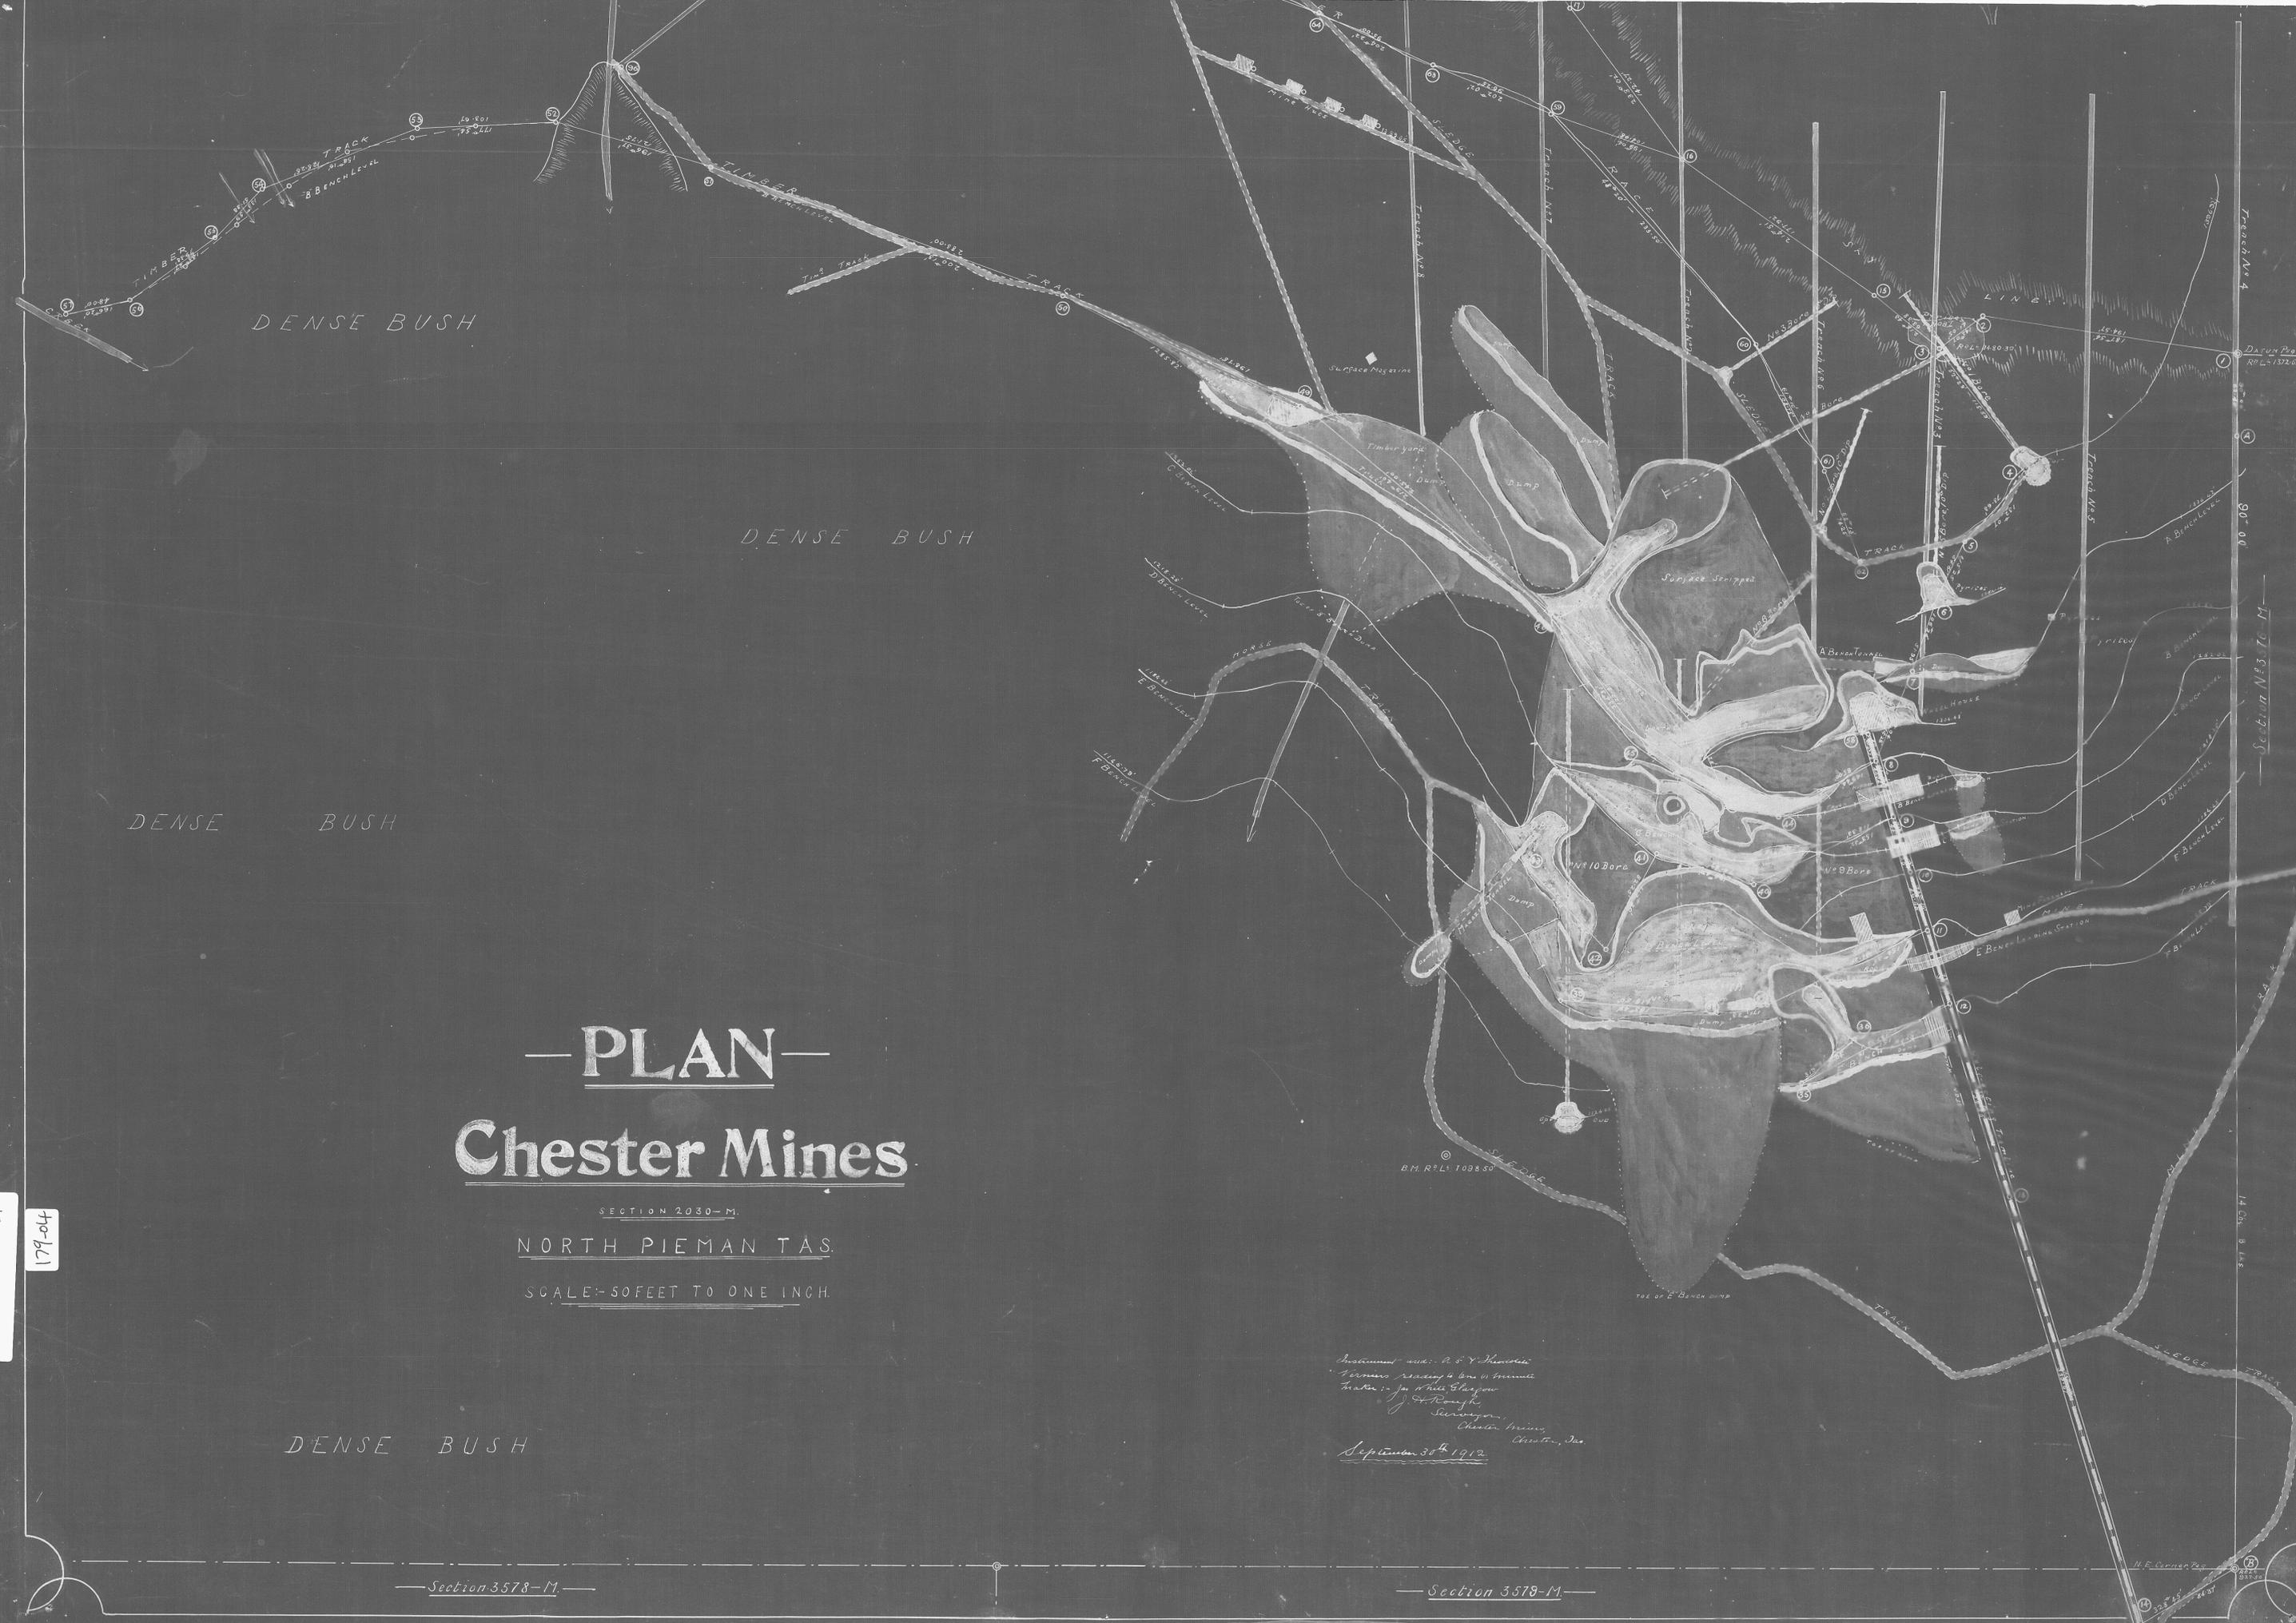

—PLAN—
Chester Mines

SECTION 2030-M
 NORTH PIEMAN T.A.S.
 SCALE—50 FEET TO ONE INCH.

179-04
 5 cm

DENSE BUSH

*Instrument used: A. & V. Schmidt
 Traverses running to base of tunnel
 Made by: J. W. Hill, Glasgow
 J. R. Rough
 Surveyor,
 Chester Mines,
 Chester, Tas.
 September 30th 1912.*

—Section 3578-M—

—Section 3578-M—

M. E. Cannon Pat.
 327,825
 327,826