

5.0m

130-01



M^T BALFOUR PLAN OF WORKINGS MURRAY'S REWARD SECTION

Scale 40 feet to an inch


Survey commenced 28. 1. 11
Finished 31. 1. 11

A. W. Morrison
Mining Surveyor

Levels shewn in RED

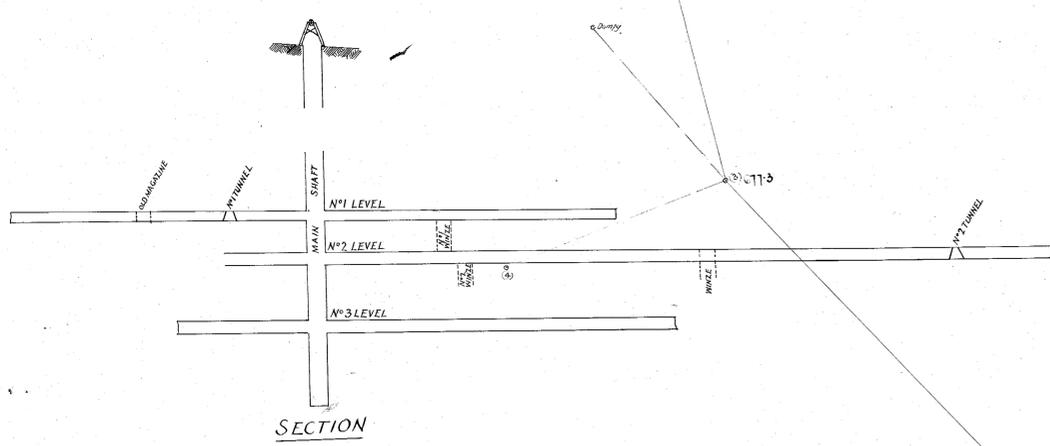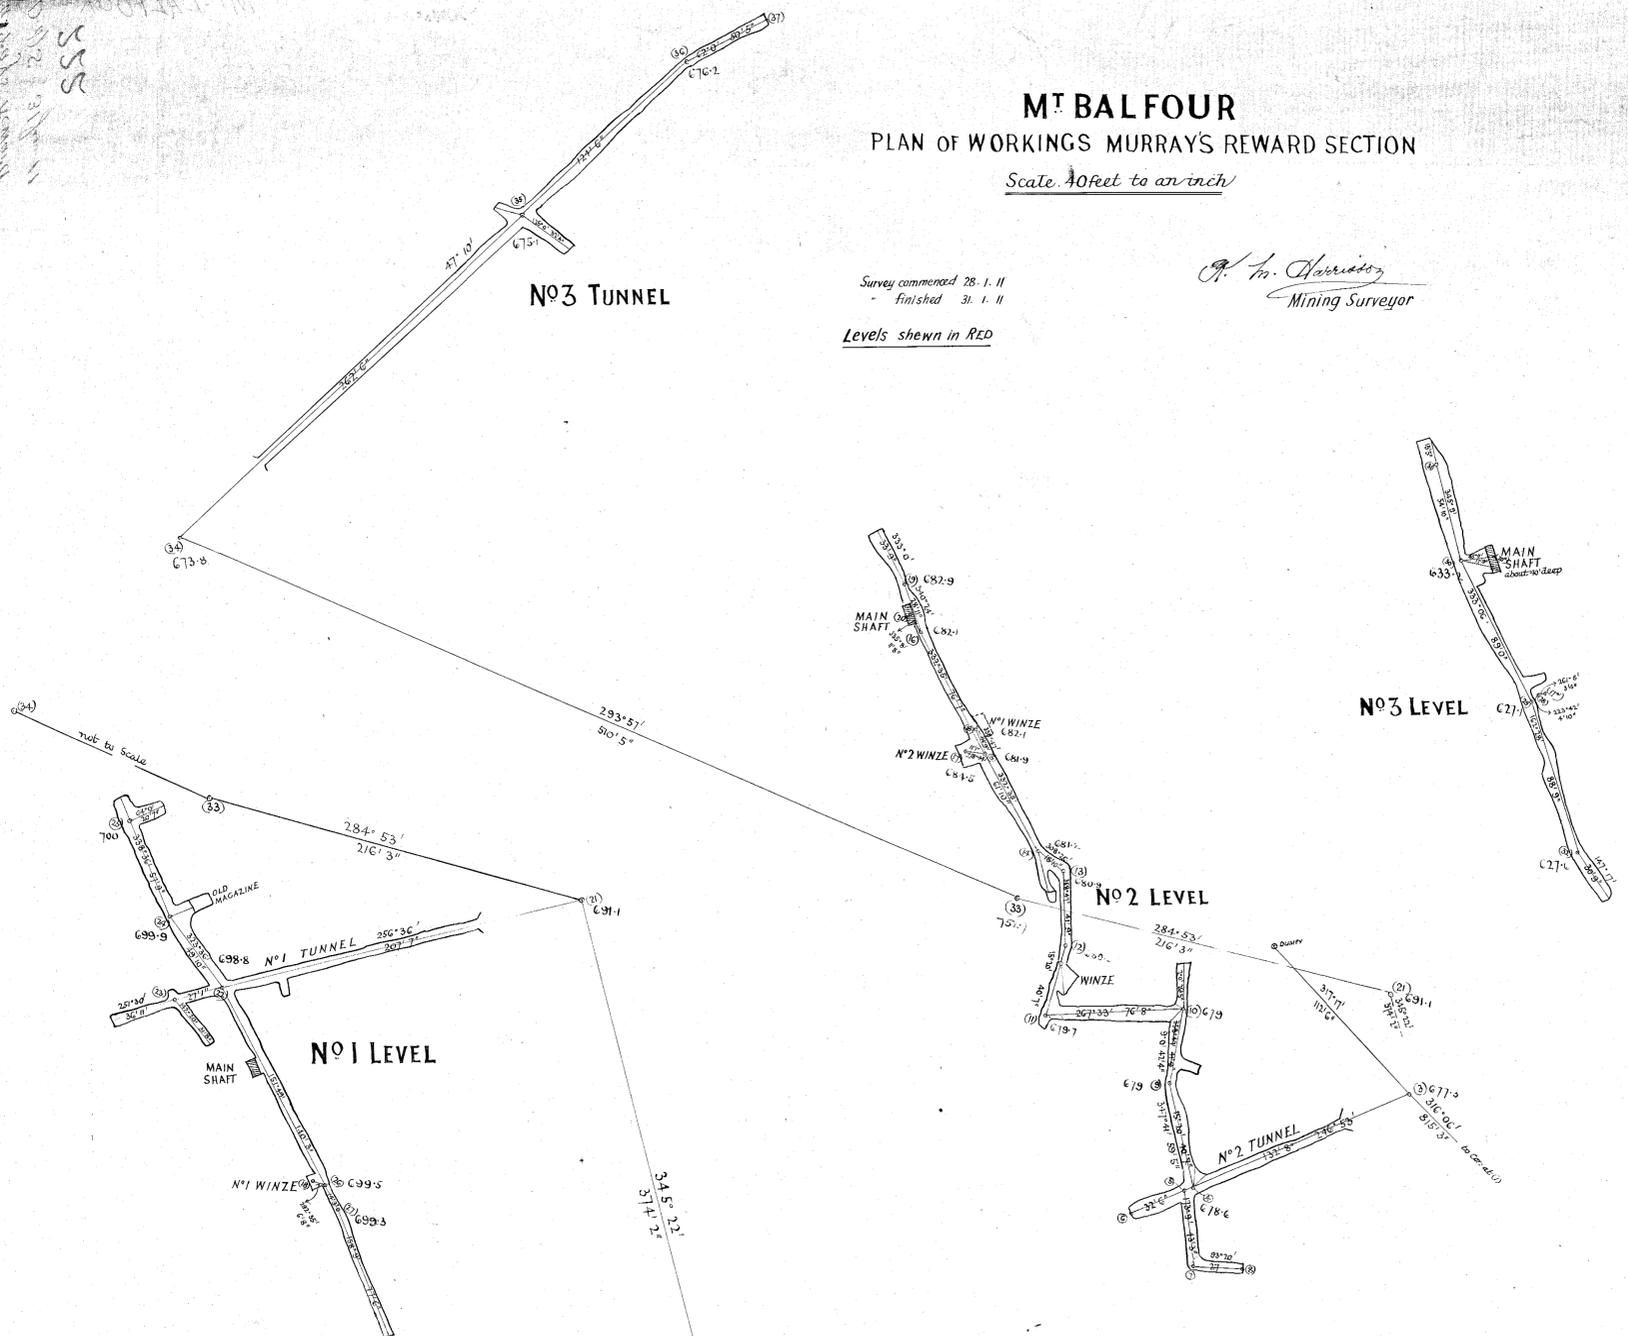

Scale 40 feet to 1 inch

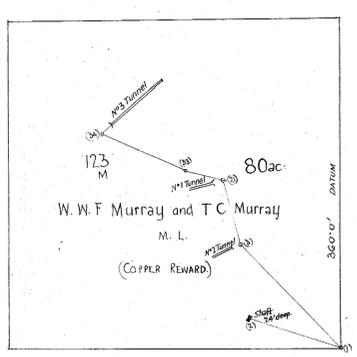

SHAFT 24' deep (2) C80-4

DATUM 360' 0"

700' Datum of Levels
SE Corner of Section N° 123