
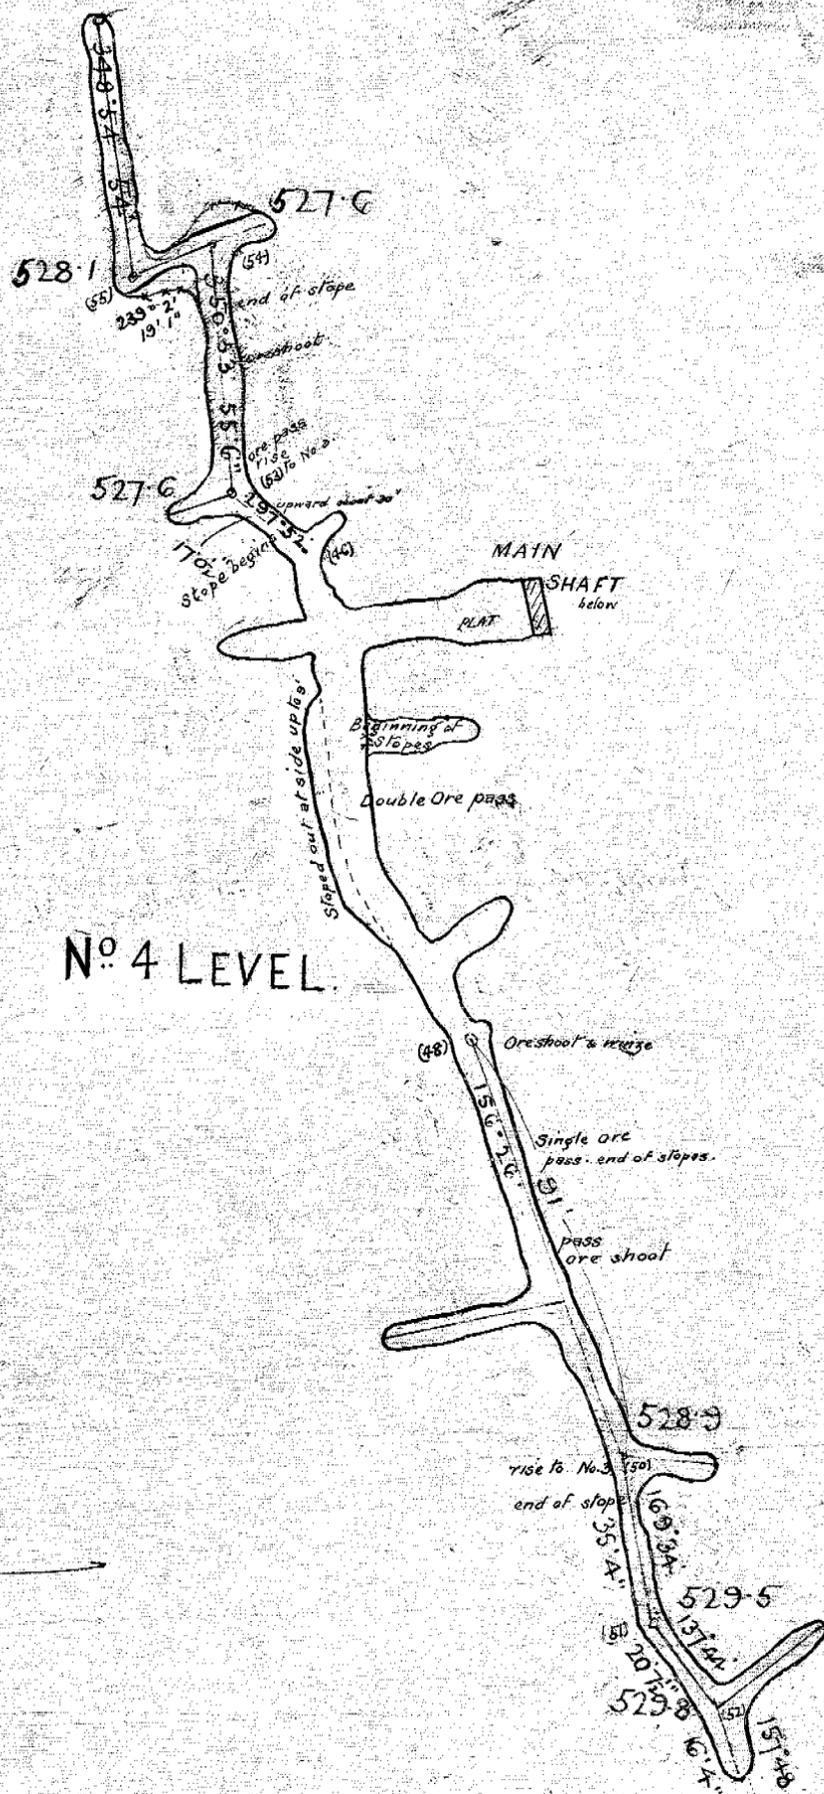


PLAN OF NO 4 LEVEL
MURRAY'S REWARD MINE
WORK PERFORMED DURING 1912
COLORED YELLOW

5 cm

0-02

Scale 40 FT. to an inch
Levels in red
Instrument 5 in theodolite

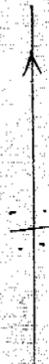

A. M. Harrison
District Surveyor