

181-01

# MT BALFOUR COPPER MINES

NO LIABILITY

PLAN OF UNDERGROUND WORKINGS

Scale 40 feet to an inch



Survey commenced 1. 2. 11  
Finished 2. 2. 11  
Levels shown in red.



*A. M. Harrison*  
Mining Surveyor

2699 M 40ac  
A. V. Chester  
M. L.

2698 M 80ac  
W. B. Collins & others  
M. L.

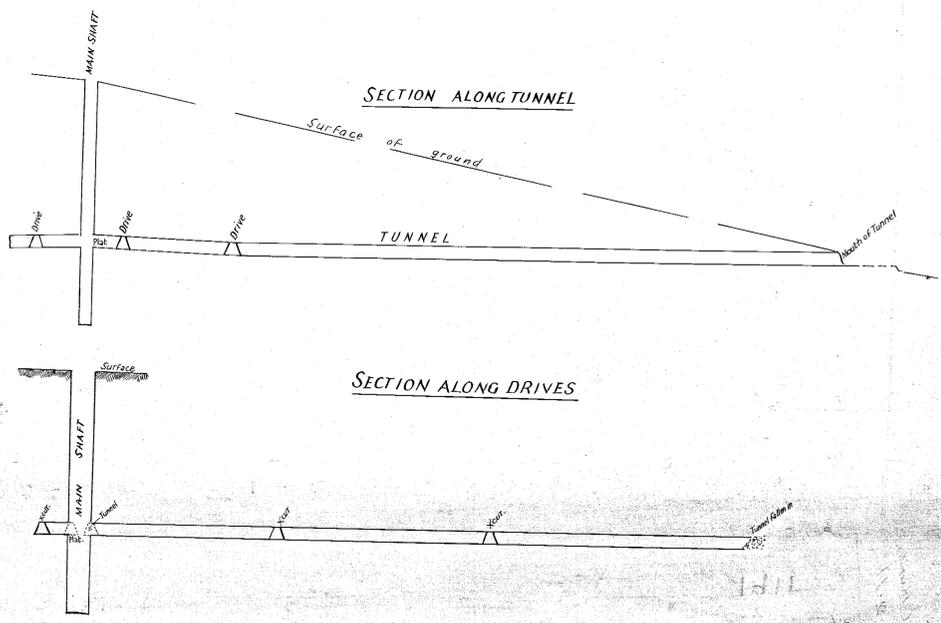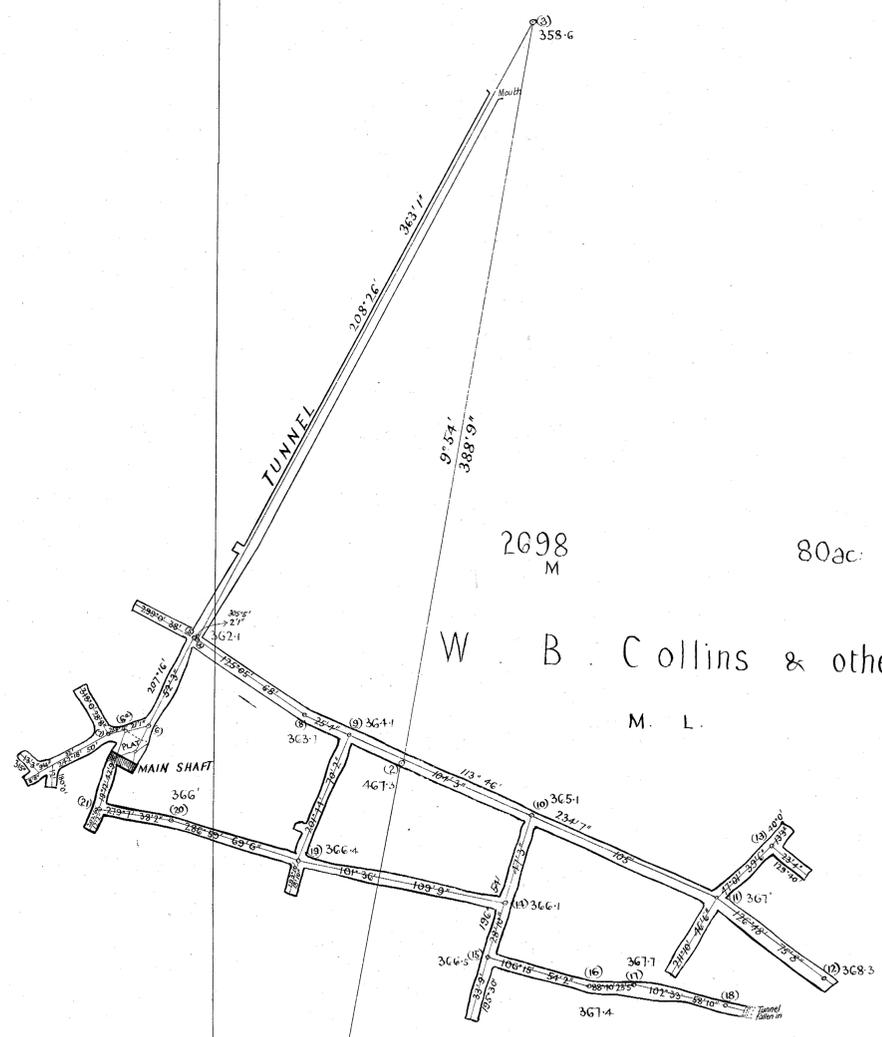

old marked line 270° 0' DATUM  
old marked line  
old corner to (0.500 ft. top of peg)  
Datum of Levels

582