


EAST NEW CHUM G.M. Co's CLAIM


LEFROY

Scale. 25 feet to One inch.

183-01

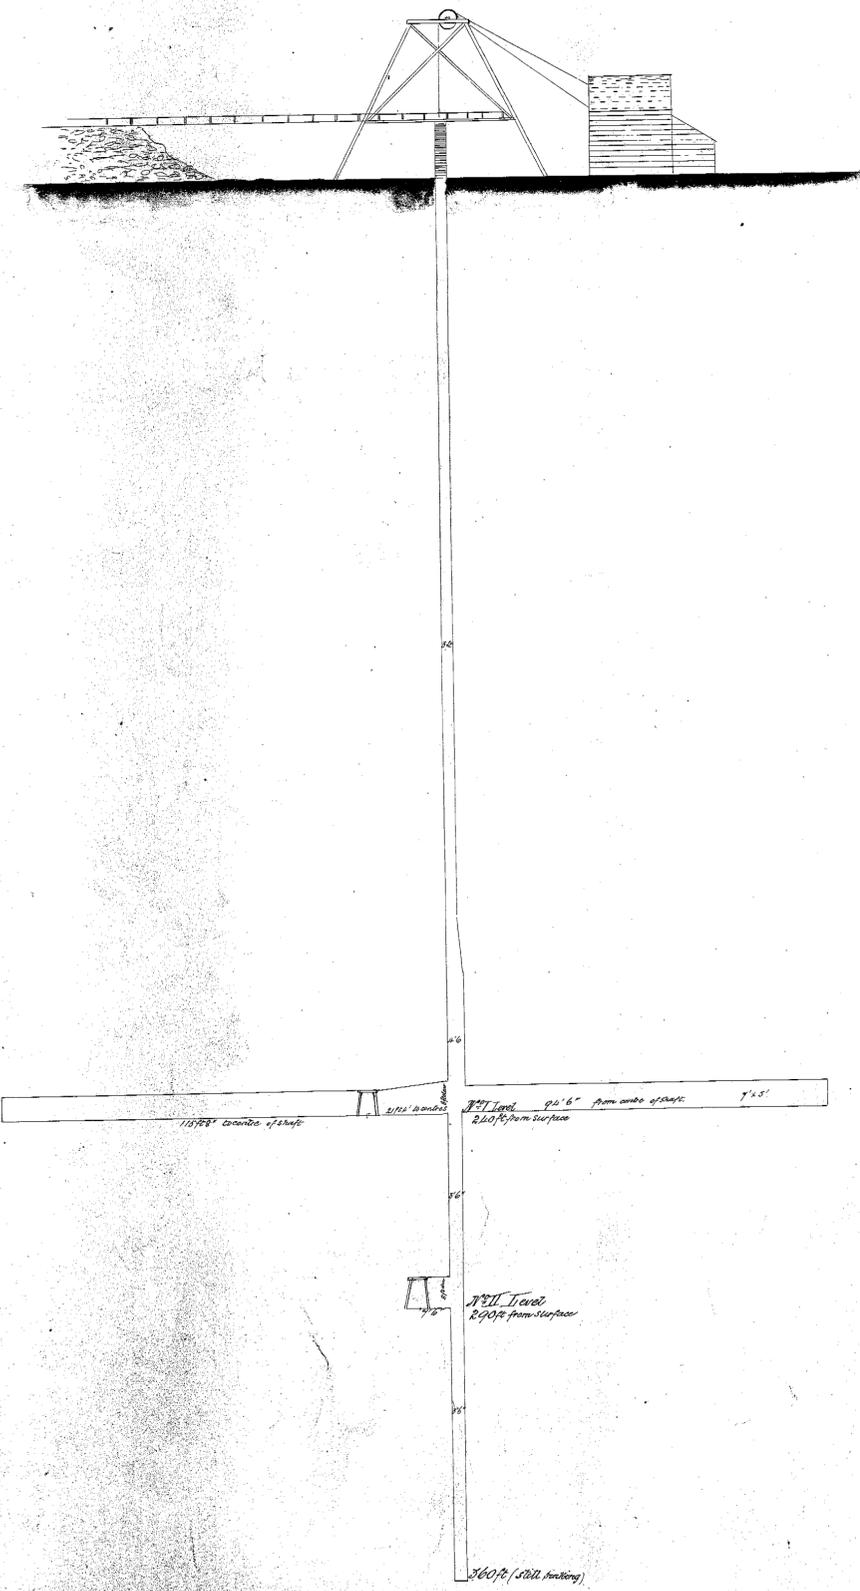

Section Looking West.

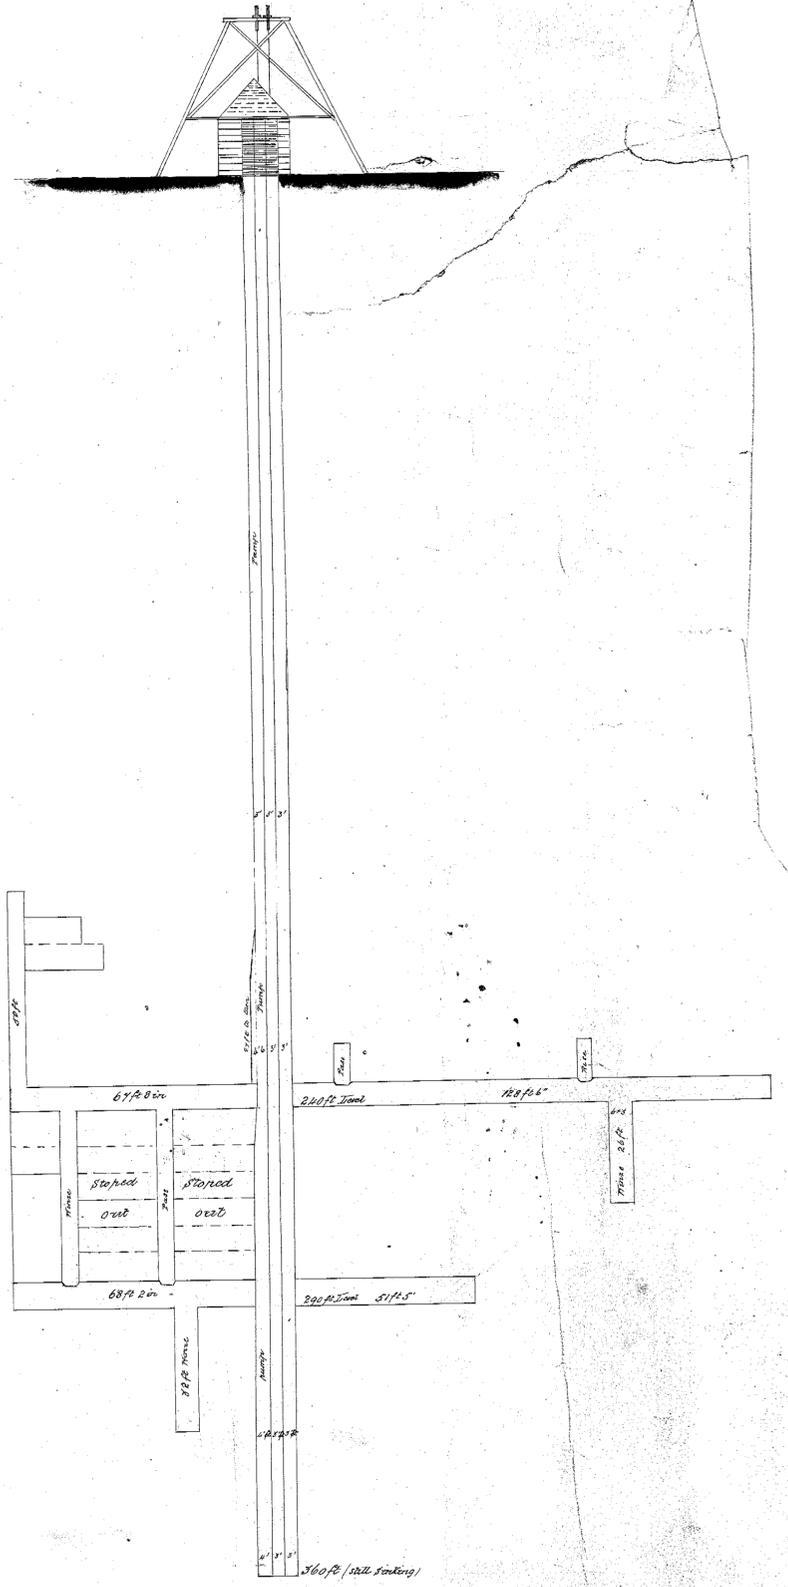

Section Looking North.

Chief Mining Surveyor  
28<sup>th</sup> March 1883

183-02