


New East Claim G M C<sup>o</sup> No 11A

Scale 25 feet to an inch


Ground Plan

Reference

- N<sup>o</sup> 1 Level (Magnetic)
- N<sup>o</sup> 2 Level
- N<sup>o</sup> 3 Level
- N<sup>o</sup> 4 Level

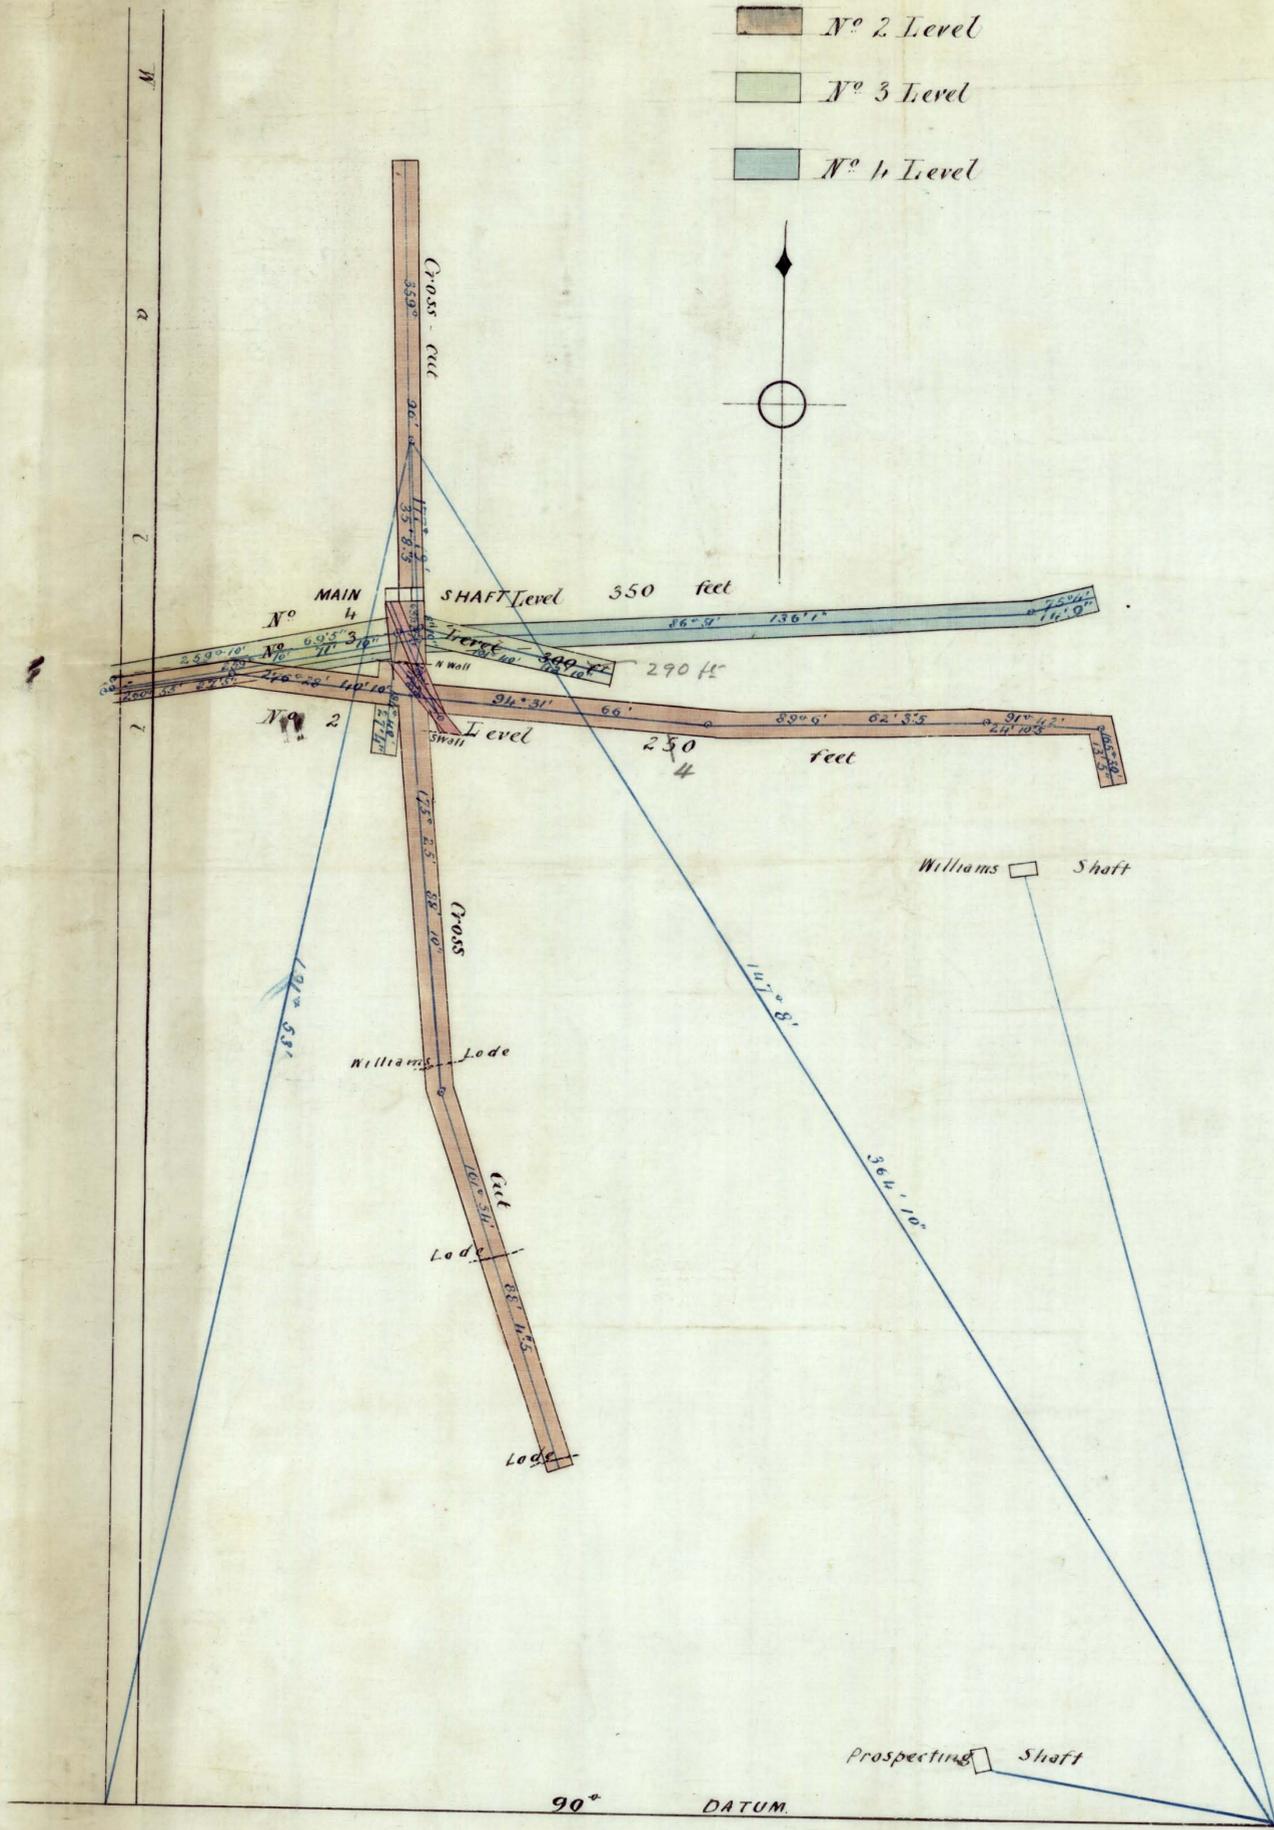

11  
 2081 1/2  
 1000

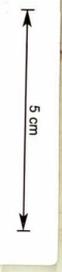

183-02

183-02

Correct copy of Plan from  
 actual Survey  
 A. J. Miles.  
 Authorized Surveyor  
 Lefroy  
 4<sup>th</sup> June 1895.

15

15