

5 cm

183-03

New East Chum G M Co

References

- N^o 1 Level
- N^o 2 Level
- N^o 3 Level
- N^o 4 Level
- Ground Stopped


No Liability

Scale 25 feet to an inch


Transverse Section



New East Chum G M Co
1881-1895

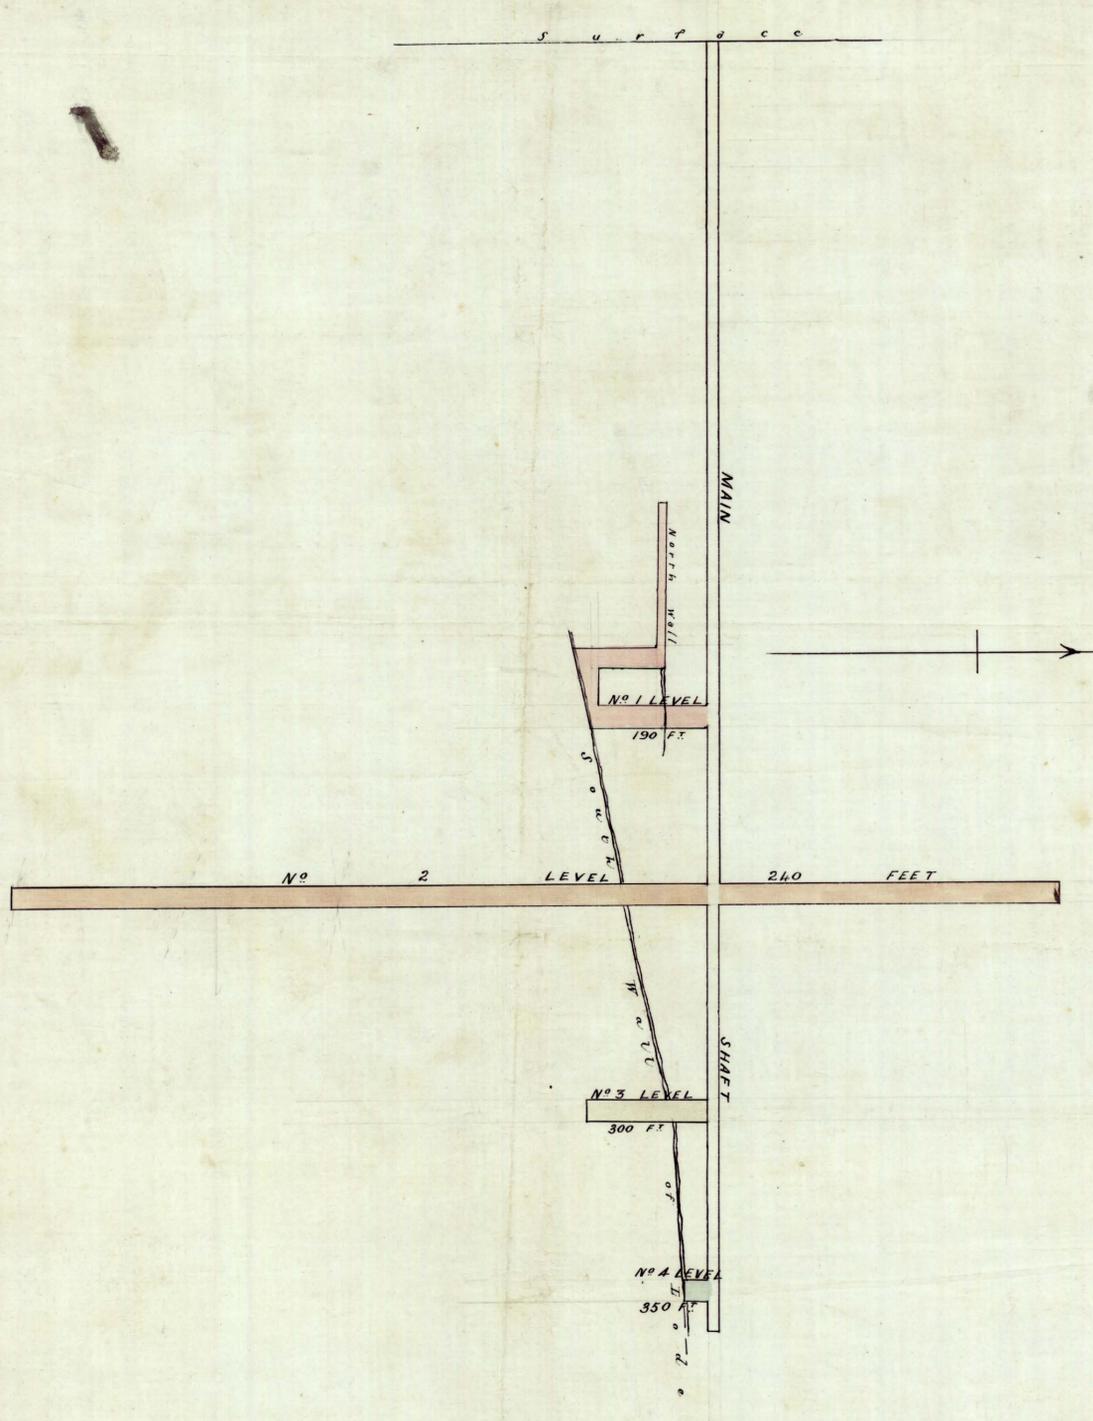

Longitudinal Section

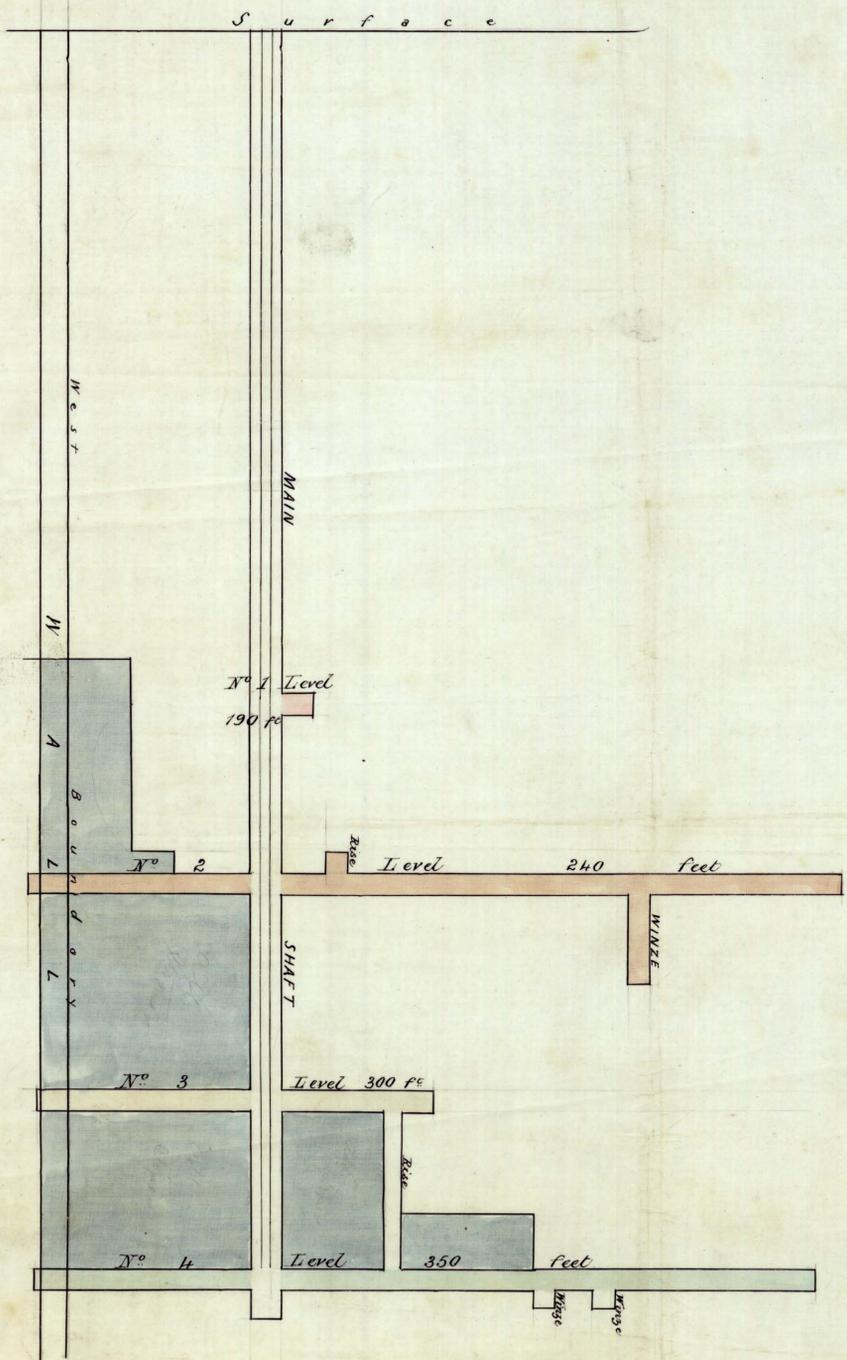

Tracing from plan from
Actual Survey
H. J. Miles.
Authorized Surveyor
Sept 4
14th June 1895.
1895