


18304



NEW EAST CHUM. G. M. C^o NO LIA

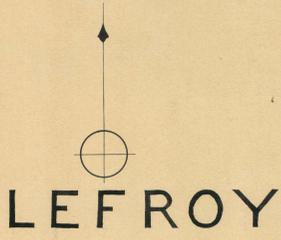

Scale 25 feet to an inch

Reference

- N^o 1 Level (Magnetic)
- N^o 2 Level
- N^o 3 Level
- N^o 4 Level

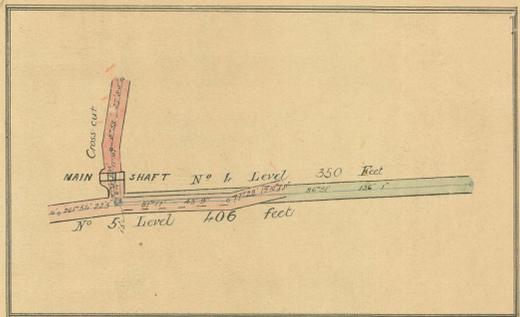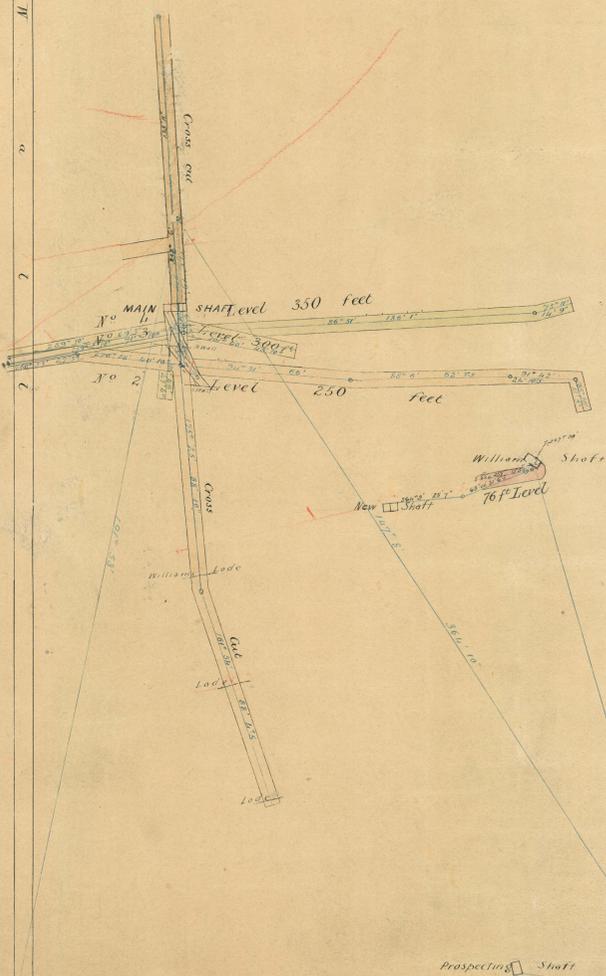

50° DATUM

Plan from actual survey.
 16 1/2 Miles.
 Authorized Surveyor
 Lefroy
 4th June 1895.