




184-01

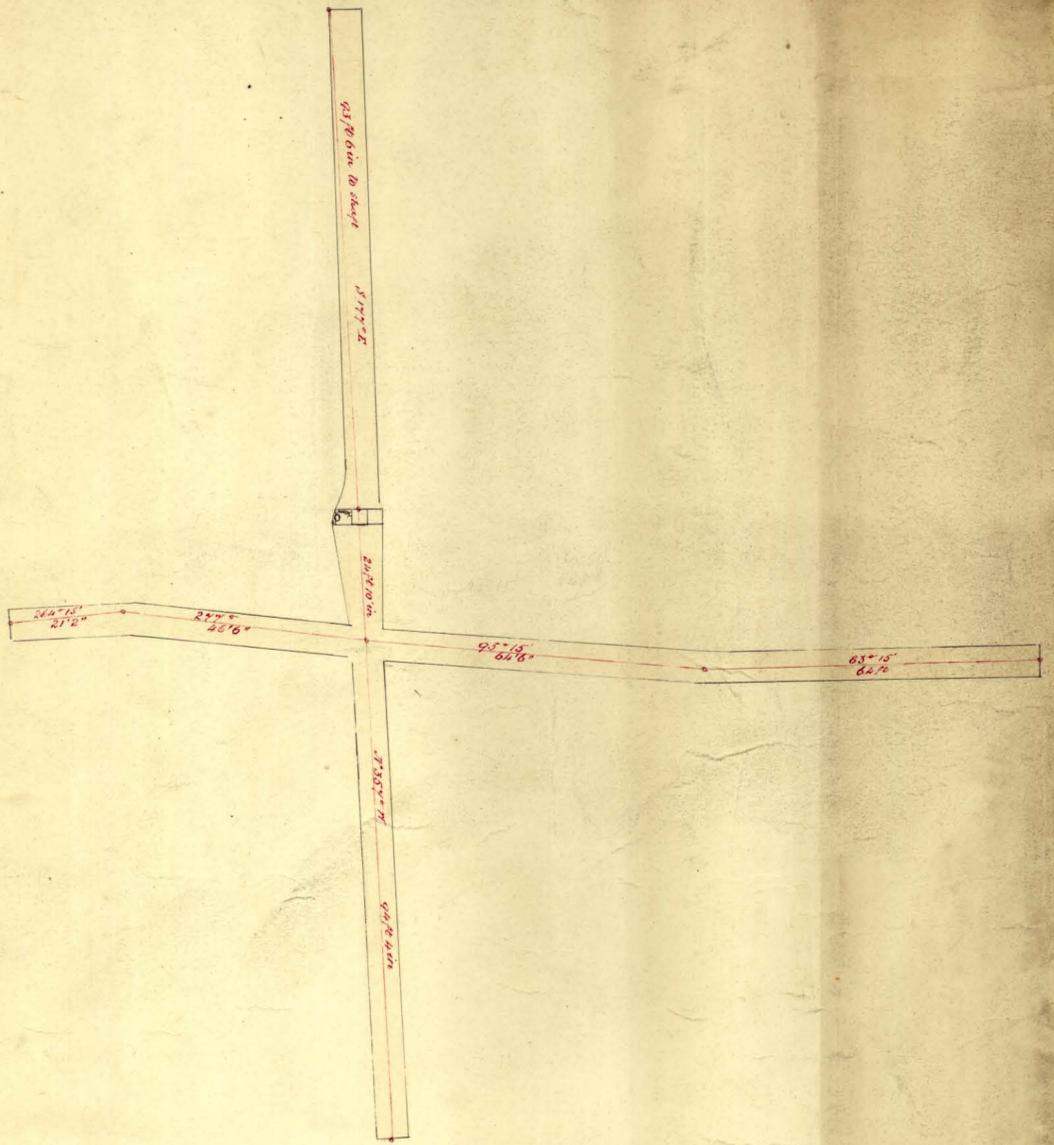

No 1 Level      Looking North.

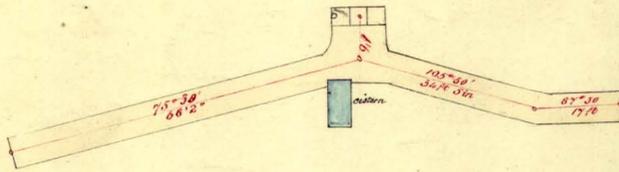

No 2 Level      Looking North.

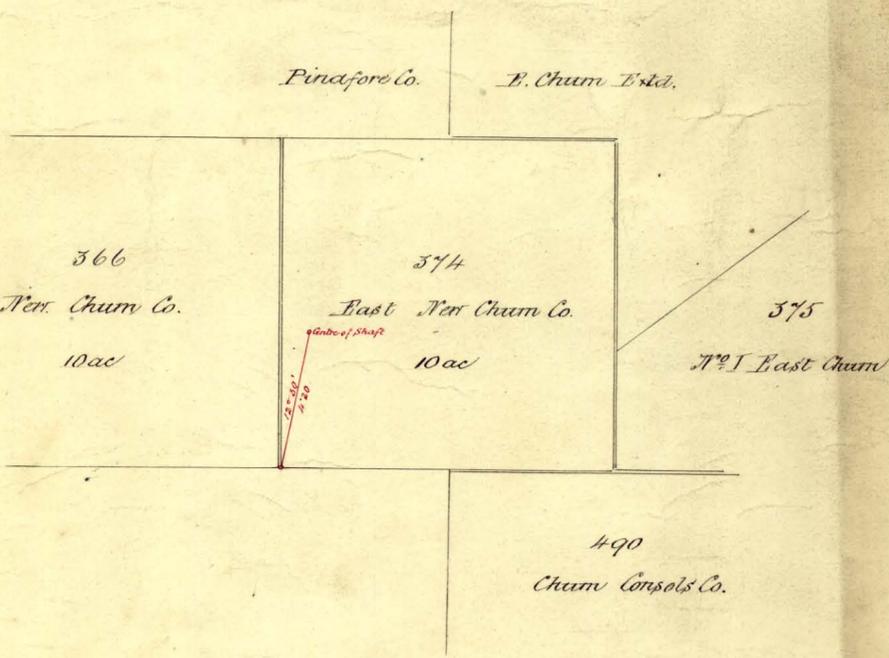

Scale. 4 chains to 1 inch.

**EAST CHUM G.M.C. CLAIM**

**LEFROY**

Scale 25 feet to One inch.

*C. W. Lord*  
Mining Surveyor  
28<sup>th</sup> March 1883.

184-01

