


184-04

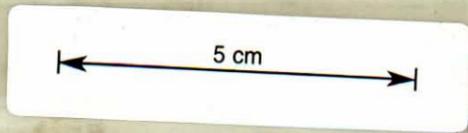





184-04

12

EAST CHUM C.M.C. NO LIA

Lefroy

Scale 25 feet to an inch

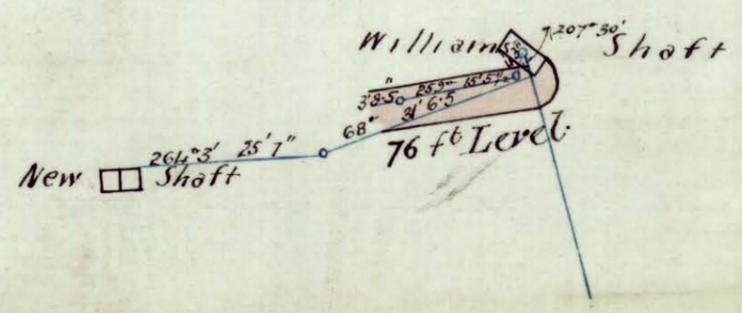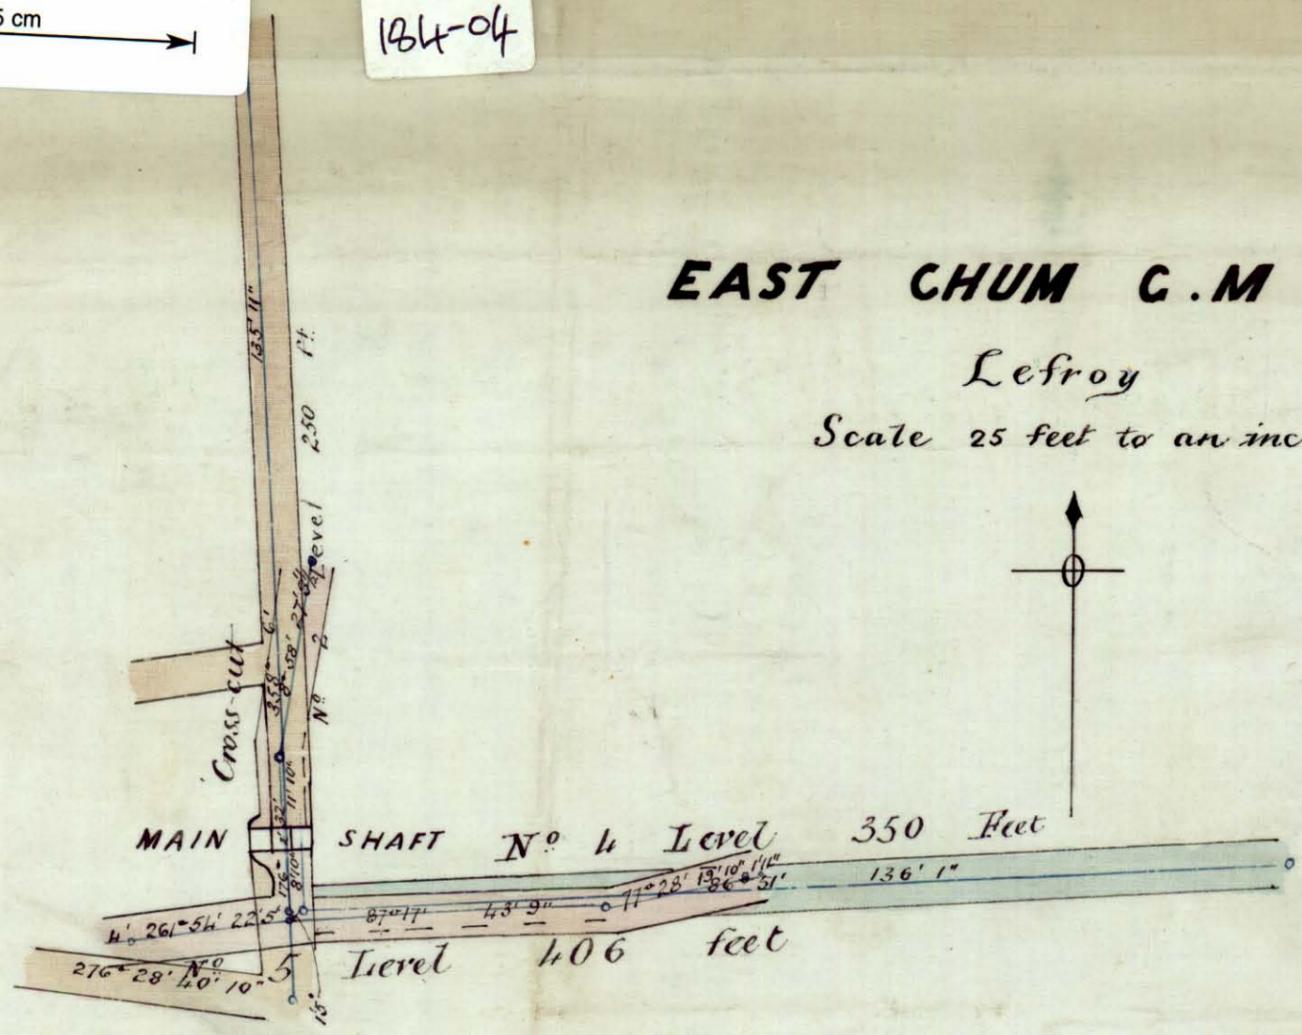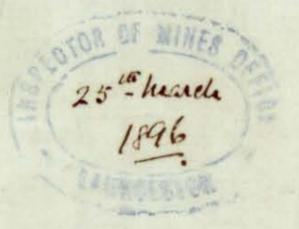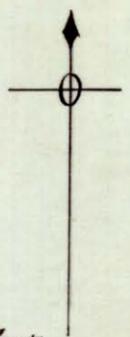

M. J. Miles.
 Authorised Surveyor
 Lefroy
 Jan'y 96

12