


SALMON GOLD ESTATES MIAMI MINE

PLAN OF WORKINGS IN THE 400 FEET LEVEL TO THE END OF APRIL 1901

Scale 25 Feet to an inch

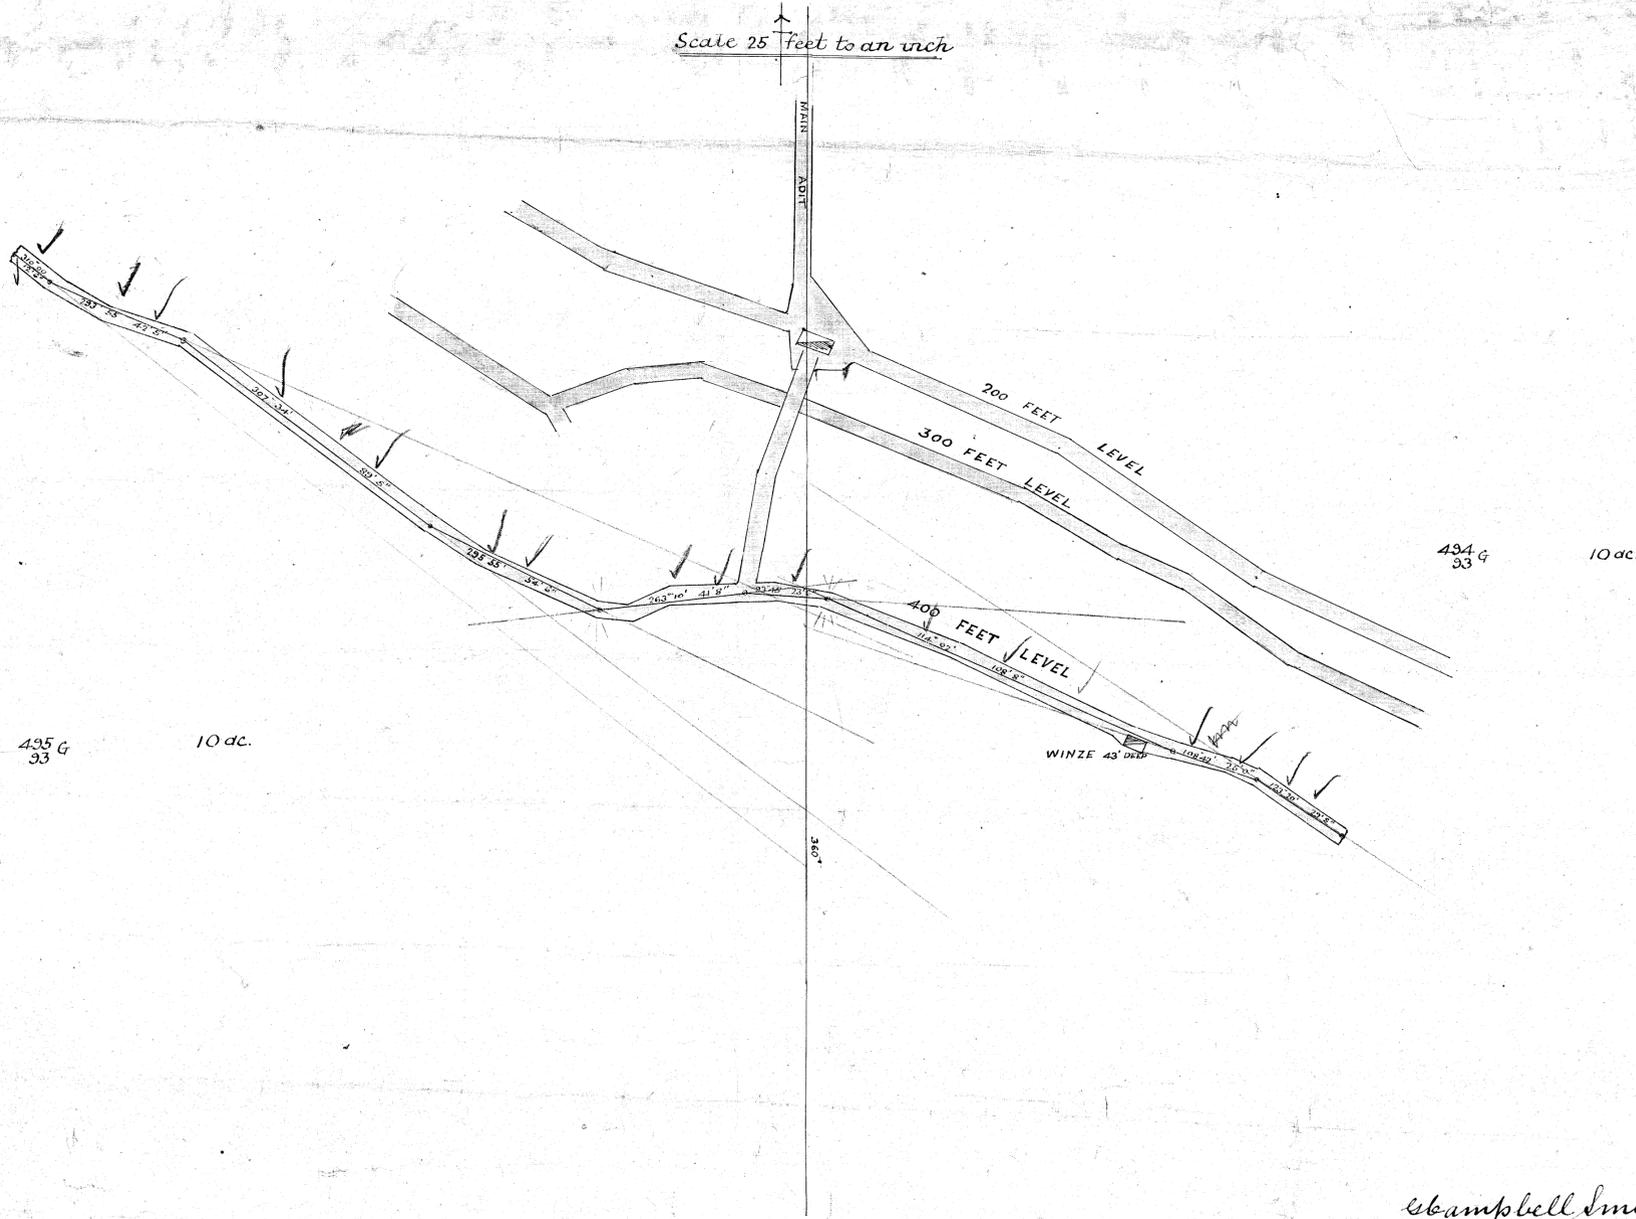

Scampbell Smith
Authorized Surveyor
May 1901
Surveyed with transit theodolite.



1001 part
1001 part
1001 part