



185-06

5m

90-581

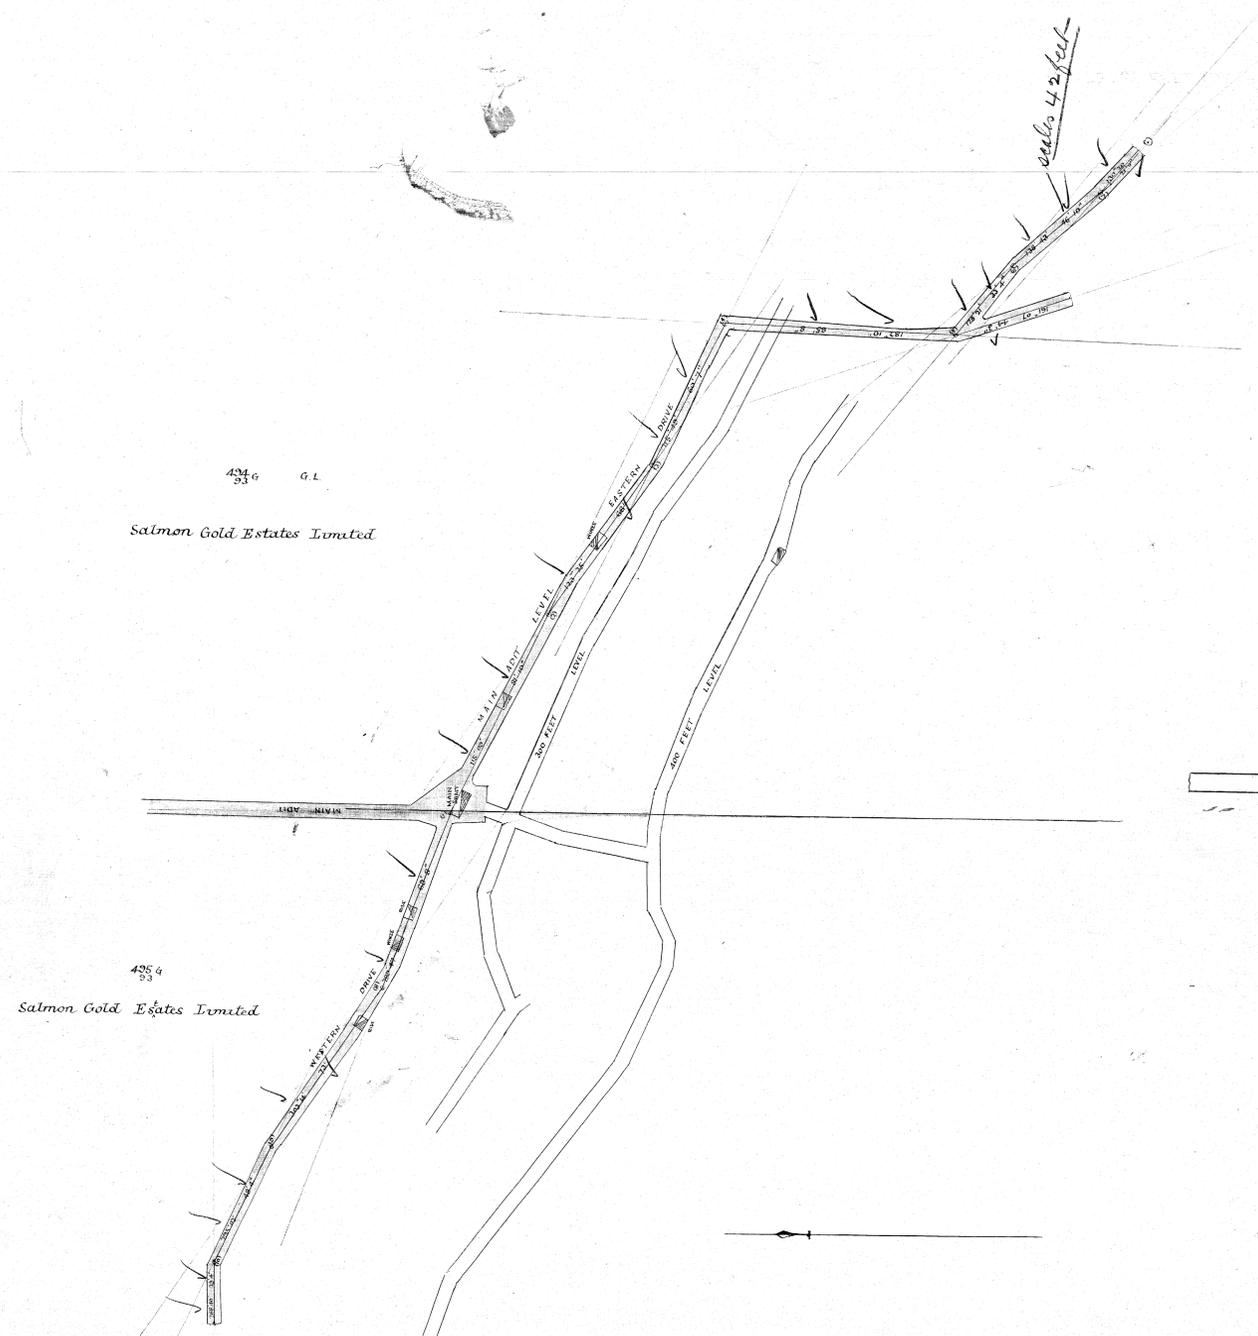

CROSS SECTION OF MAIN SHAFT
LOOKING SOUTH

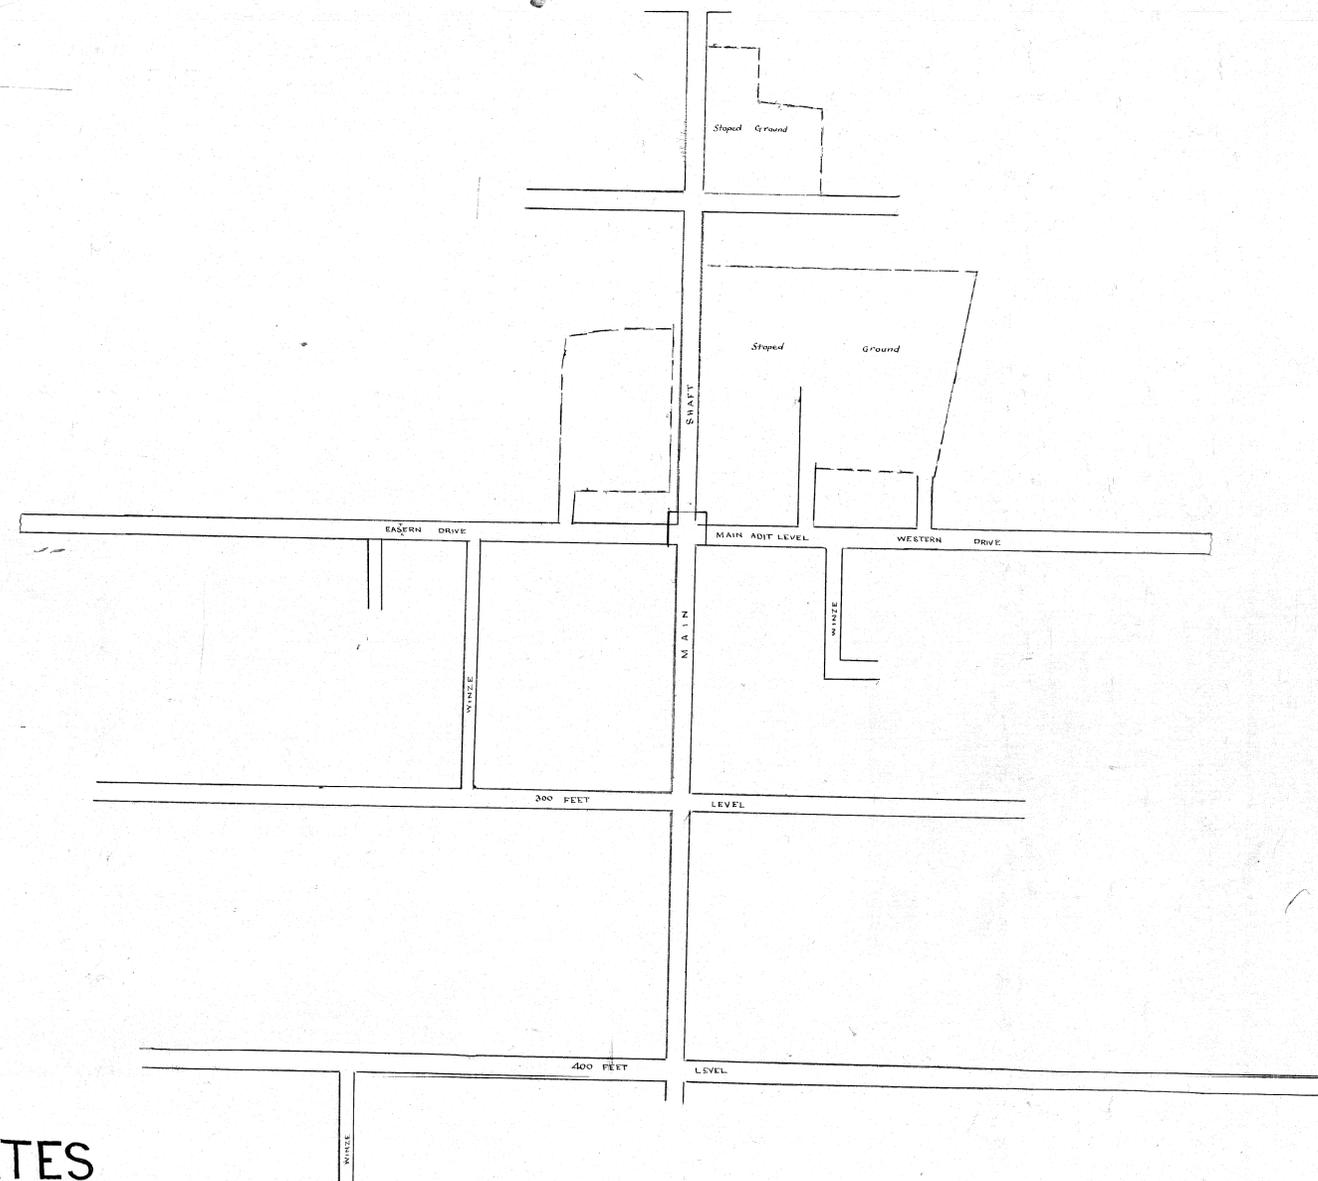

SALMON COLD ESTATES
MIAMI MINE

SCALE 25 FEET TO AN INCH

Survey Begun & Finished 11.1.02

Sampbell Smith
Authorised Surveyor

Surveyed with transit theodolite



Miami Mine
Jan 1905