

186-01


Plan and sections Cornwall Mine

M^r Nicholas, County of Cornwall

Cornwall Coal Mining Company

Horizontal scale 66 feet to an inch



1888

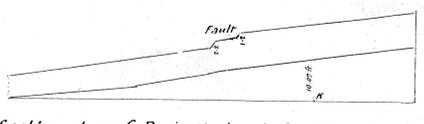


Section along C. D. vertical scale 20 feet to an inch

Plan of workings, partly from measurement and partly compiled from managers plan


The portion coloured shows headings and worked ground all being in the coal seam

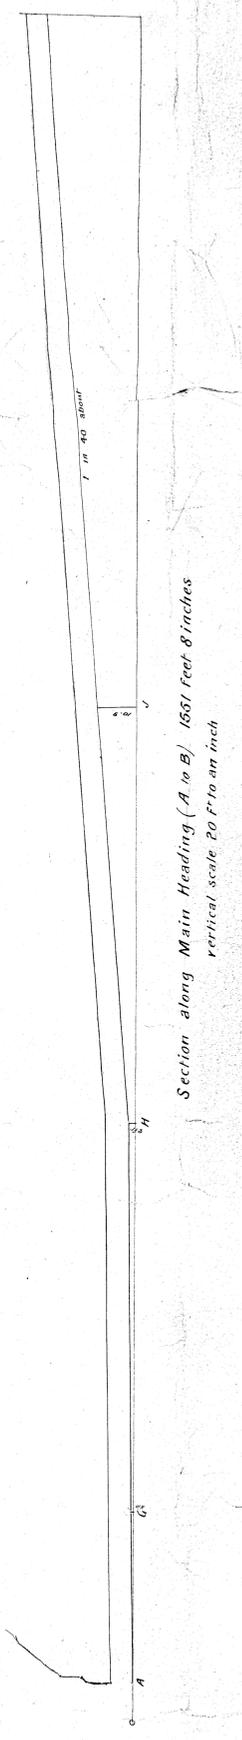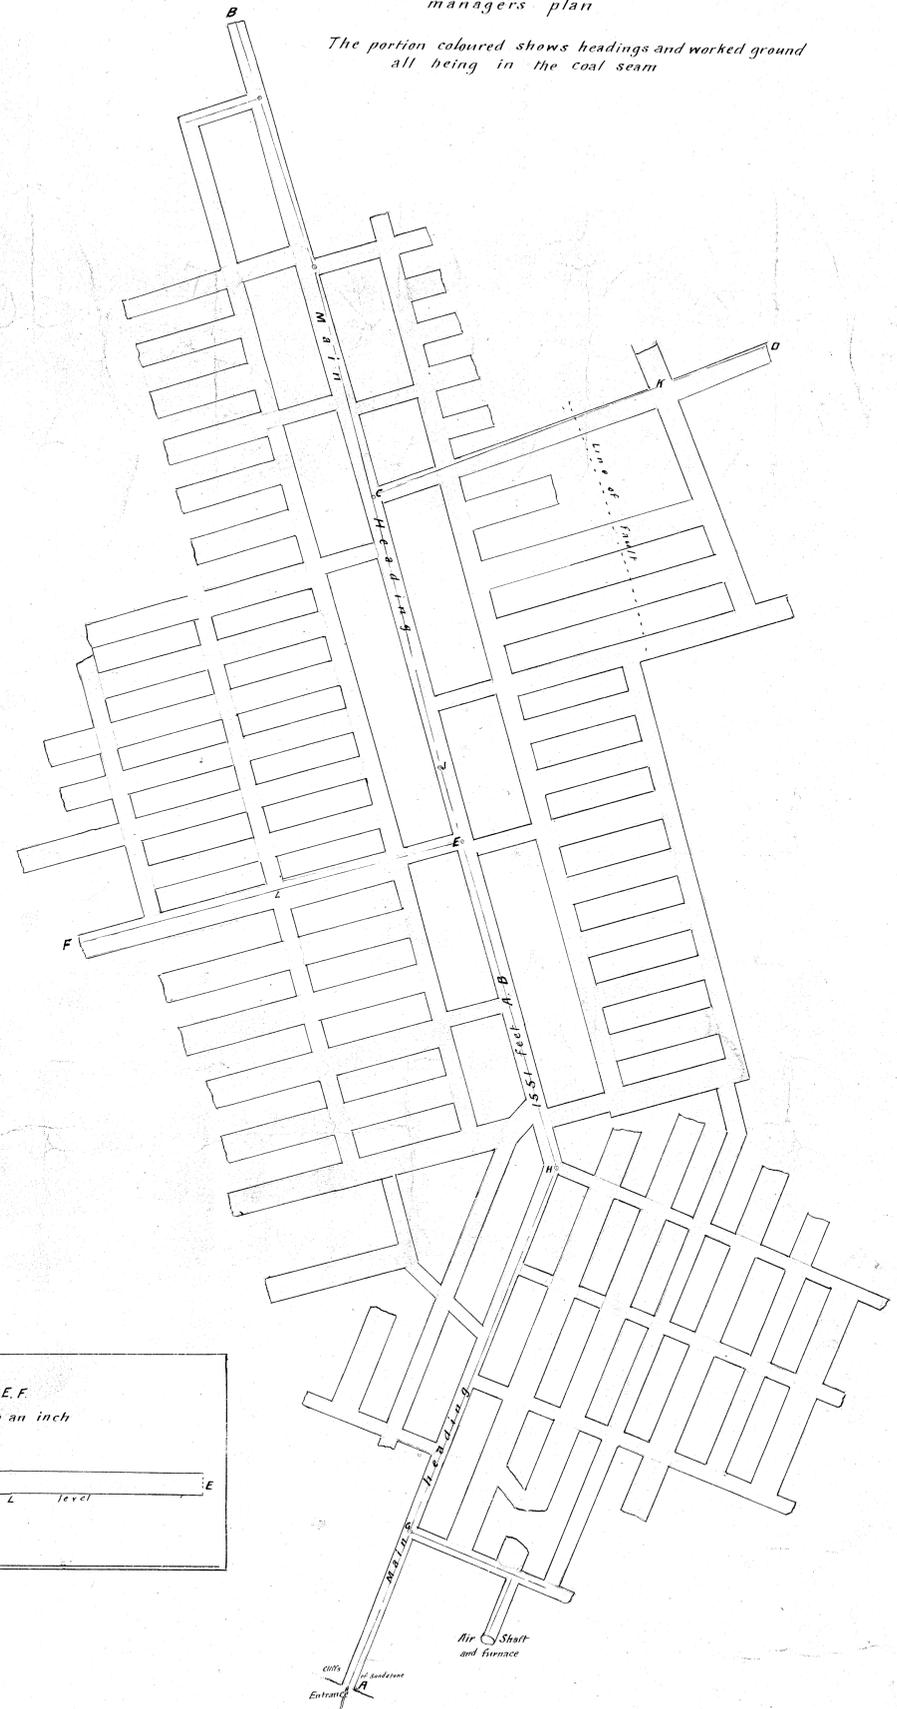

Section along Main Heading (A to B) 1651 feet 8 inches vertical scale 20 feet to an inch

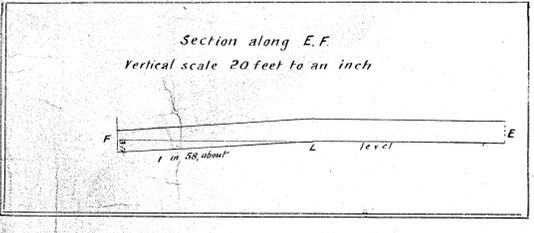

Section along E. F. vertical scale 20 feet to an inch

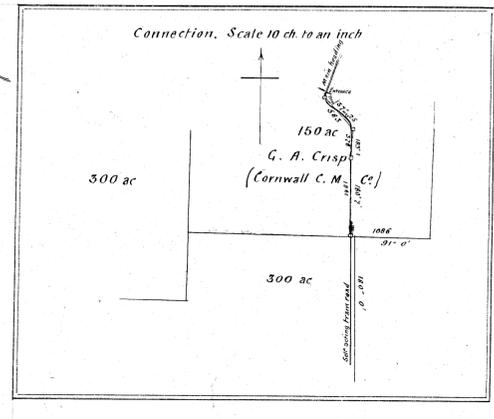

26th February 1889
George Smith