
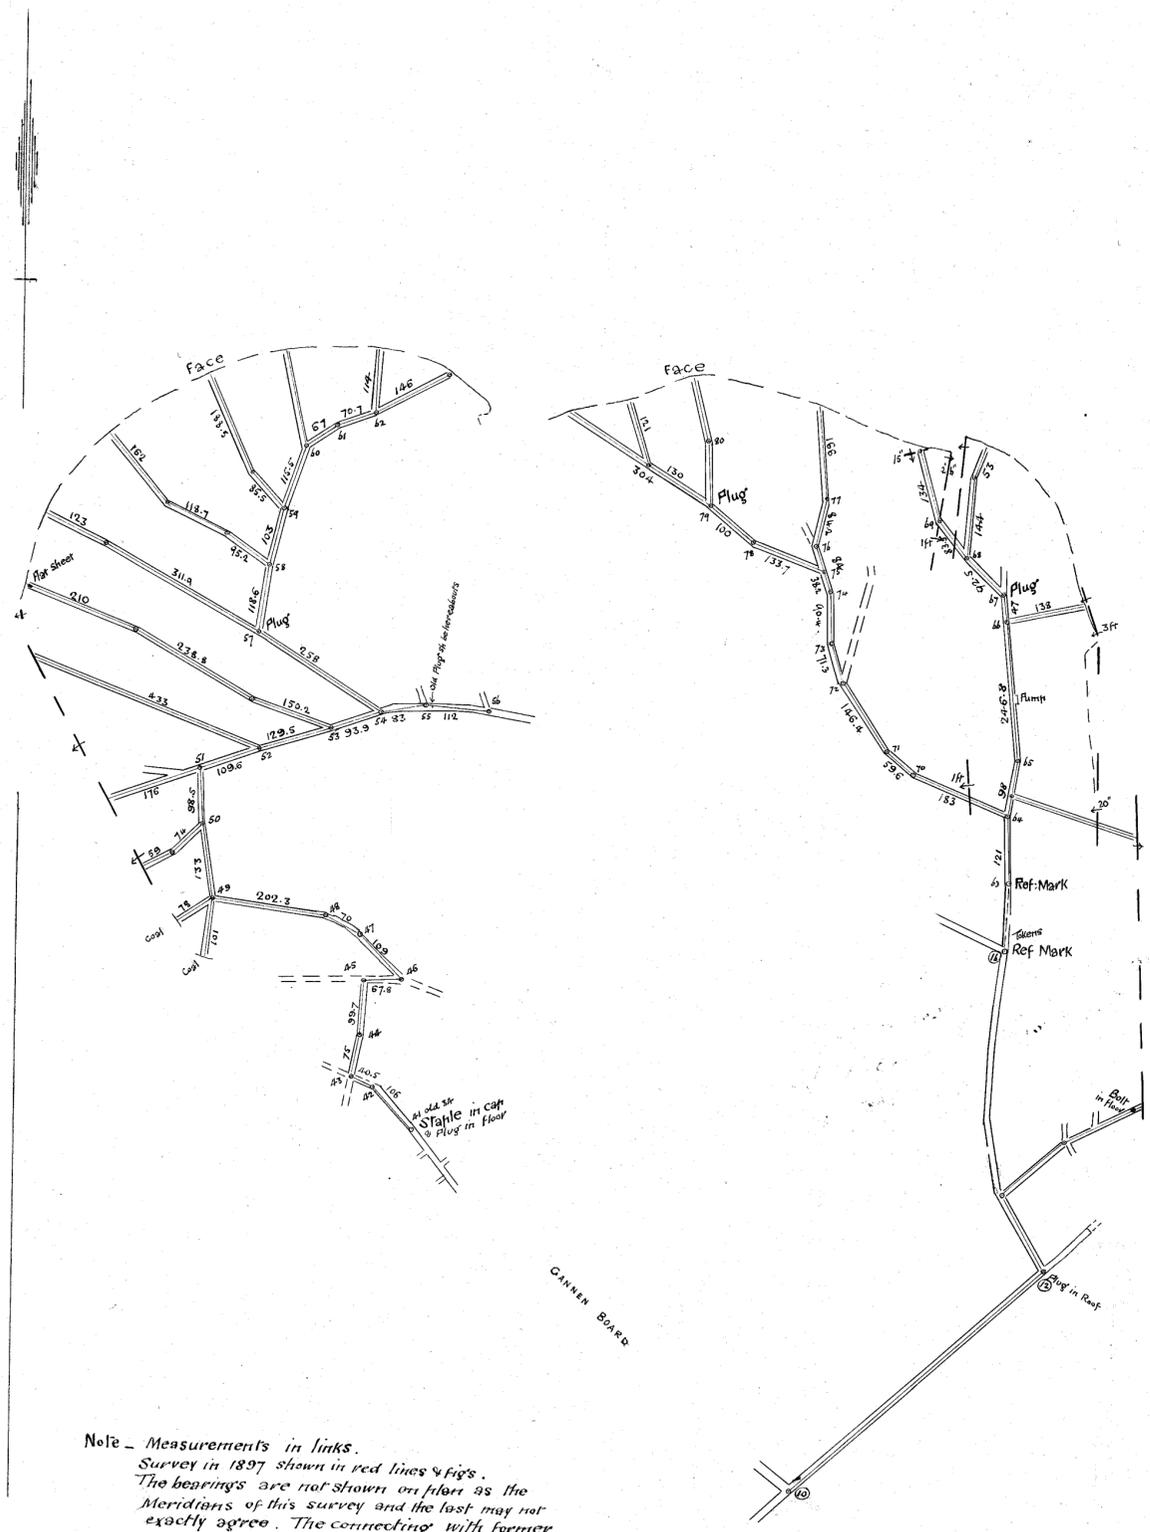


186-02
TE 81

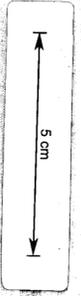

Note - Measurements in links.
Survey in 1897 shown in red lines & fig's.
The bearings are not shown on plan as the
Meridians of this survey and the last may not
exactly agree. The connecting with former
Ref Marks locate the work fairly well and a
good connection can be made next year.

M. NICHOLAS

COLLIERY
Scale 2 Chains to 1 inch
To 12th March 1897

S. Scherke
Mining Surveyor
8th April 1897

