

186-03

186-03


5 cm

The North East Workings M^r. Nicholas Colliery

TO FEBRUARY 1901

Scale 2 chains to an inch

6 ft seam

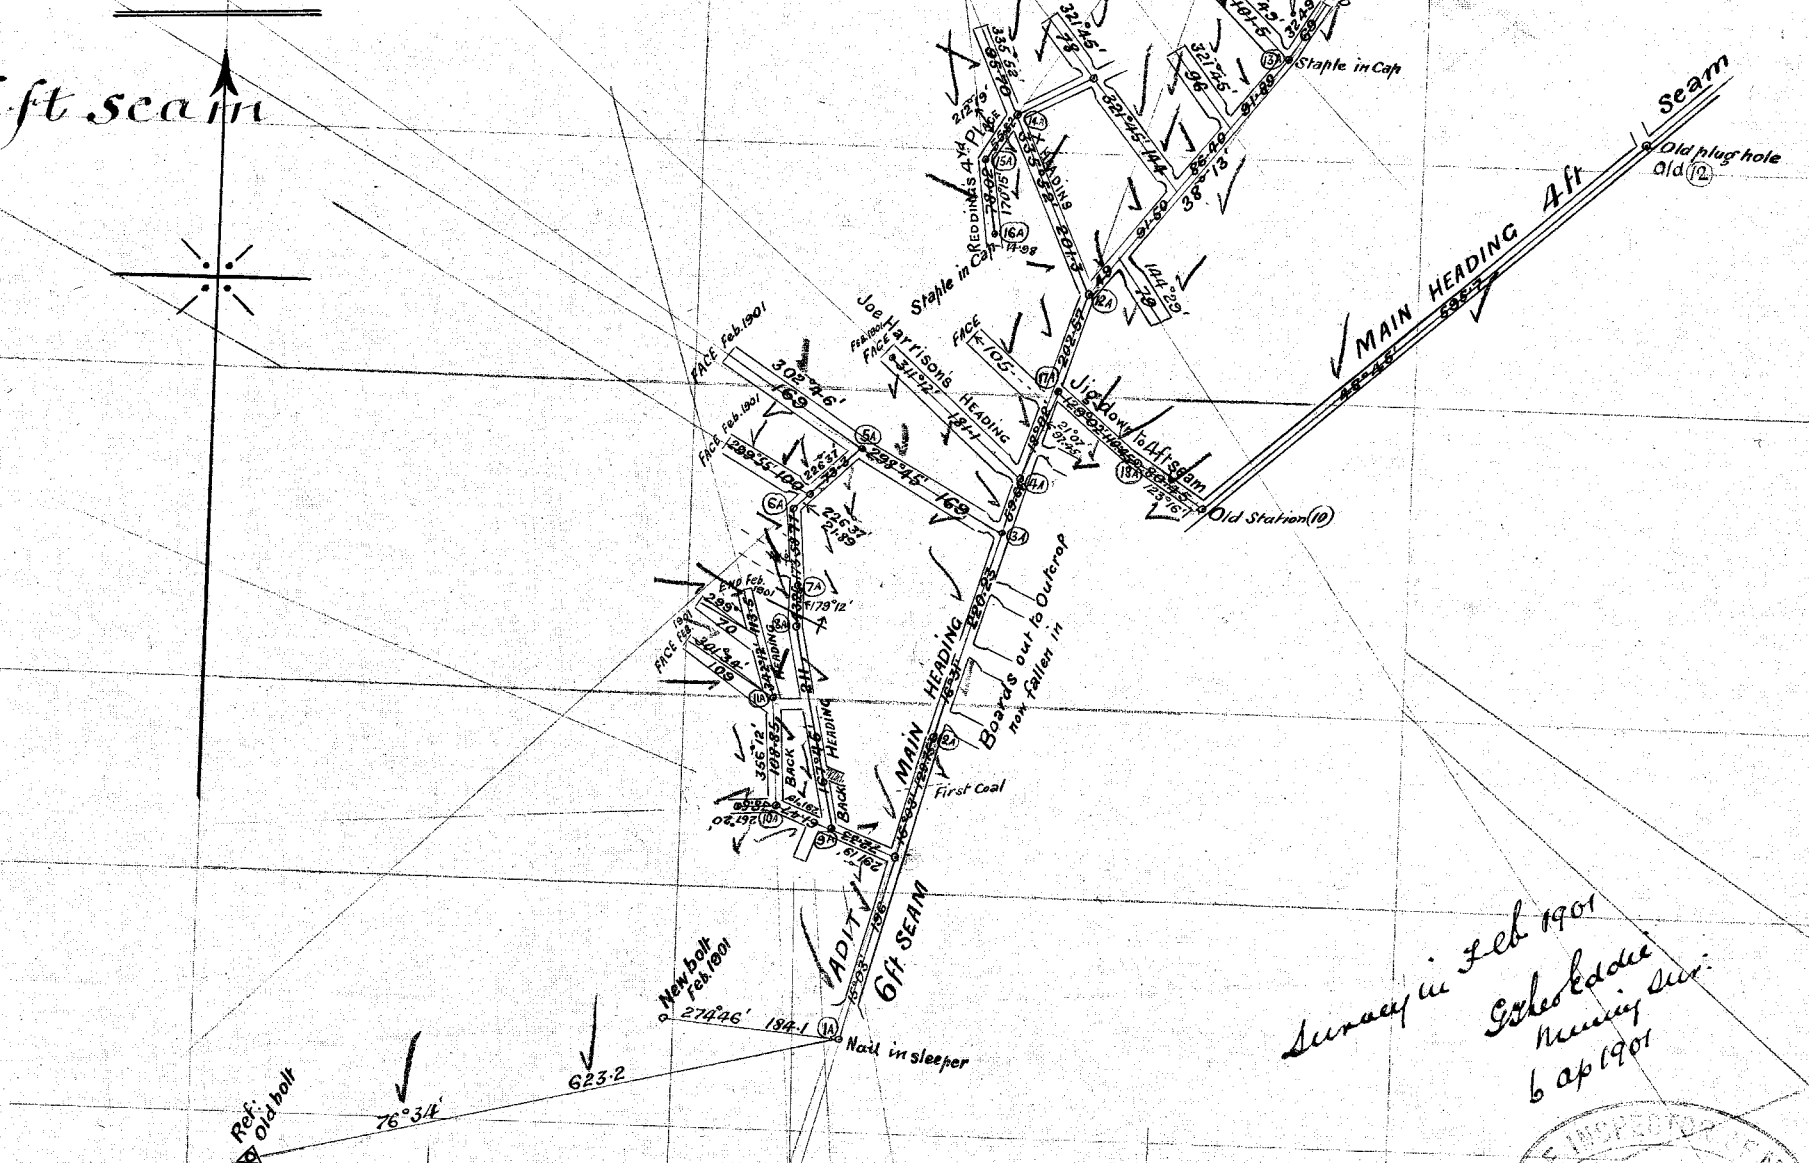

Survey in Feb 1901
G. S. K. L. L. L.
Mining Sec.
6 ap 1901

