


# M<sup>r</sup> Nicholas Colliery

TO MARCH 1902

Scale 2 chains to an inch

6ft seam

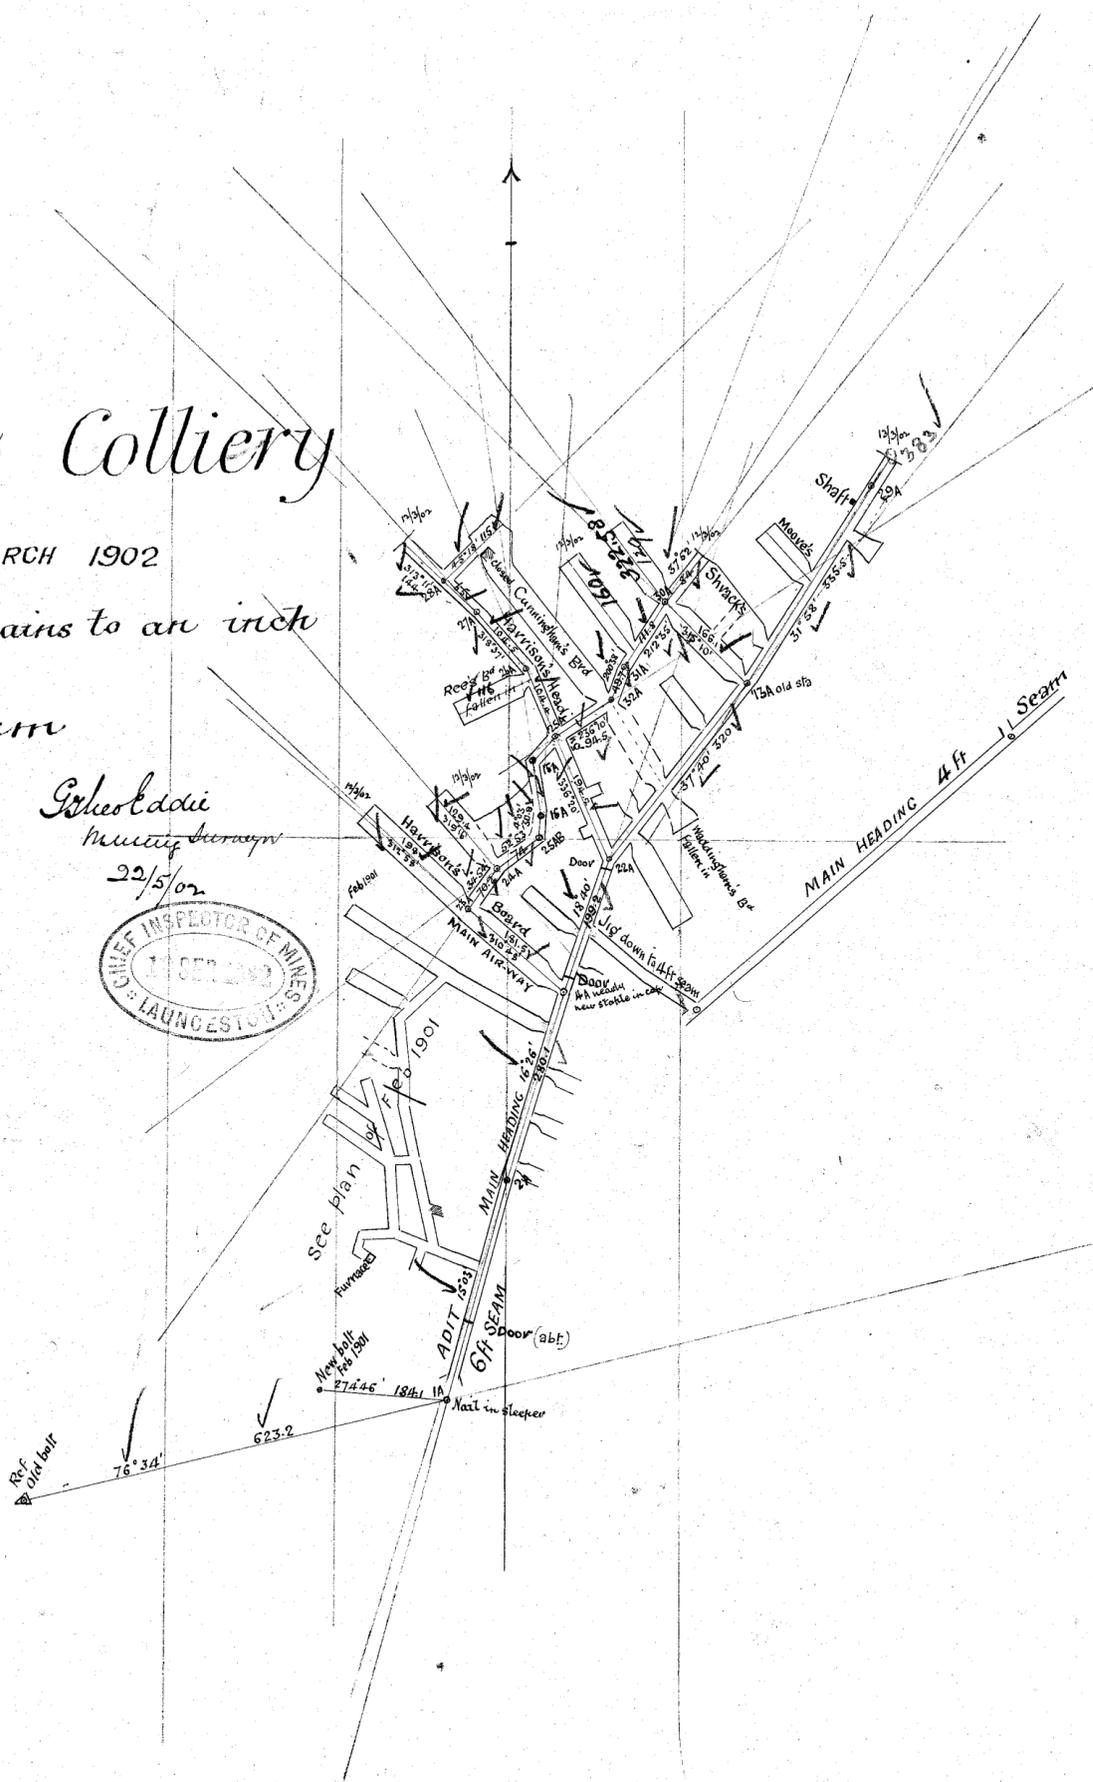

*G. Woodall*  
Mining Surveyor  
22/5/02



5 cm

186-04

186-04

20

20